



VIRGINIA POLYTECHNIC INSTITUTE AND STATE UNIVERSITY
PROCUREMENT DEPARTMENT

ADDENDUM NO. 3

DATE: May 13, 2026
TO: All Offerors
FROM: Kim Widrig, Contracting Officer
TOTAL PAGE(S): 1 page (not including attachments)
SOLICITATION TITLE: University Scholarship and Financial Aid Suite Renovation
SOLICITATION NUMBER: 049302623

I. CLARIFICATIONS AND ADDITIONAL INFORMATION

1. Second and third floor demolition plans are attached as **Exhibit A**.
2. Second and third floor lighting plans are attached as **Exhibit B**.
3. A second site visit will be held on **Tuesday, May 19 from 1:00 PM to 2:00 PM**. No additional site visits will be offered beyond this date.

II. REQUESTS FOR INFORMATION


1. Specification 122400: 2.01.A.1. specifies, "Mecho" as the BOD. Please confirm no other manufacturers are permitted.

Virginia Tech Response: See VT response to RFI #2.

2. Drawings:
 - a. What is the estimated vertical dimension(s) for the shades?
 - b. Please provide shade installation details.


Virginia Tech Response: Remove all window shades from the project. All window shades will be furnished and installed under a separate contract. Remove new work note 11 and all references to it from sheet A203. Remove new work note 9 and all references to it from sheet A204. Remove specification section 12 2400 Window Shades in its entirety from the Project Manual.

EXHIBIT A
Second and Third Floor Demolition Plans

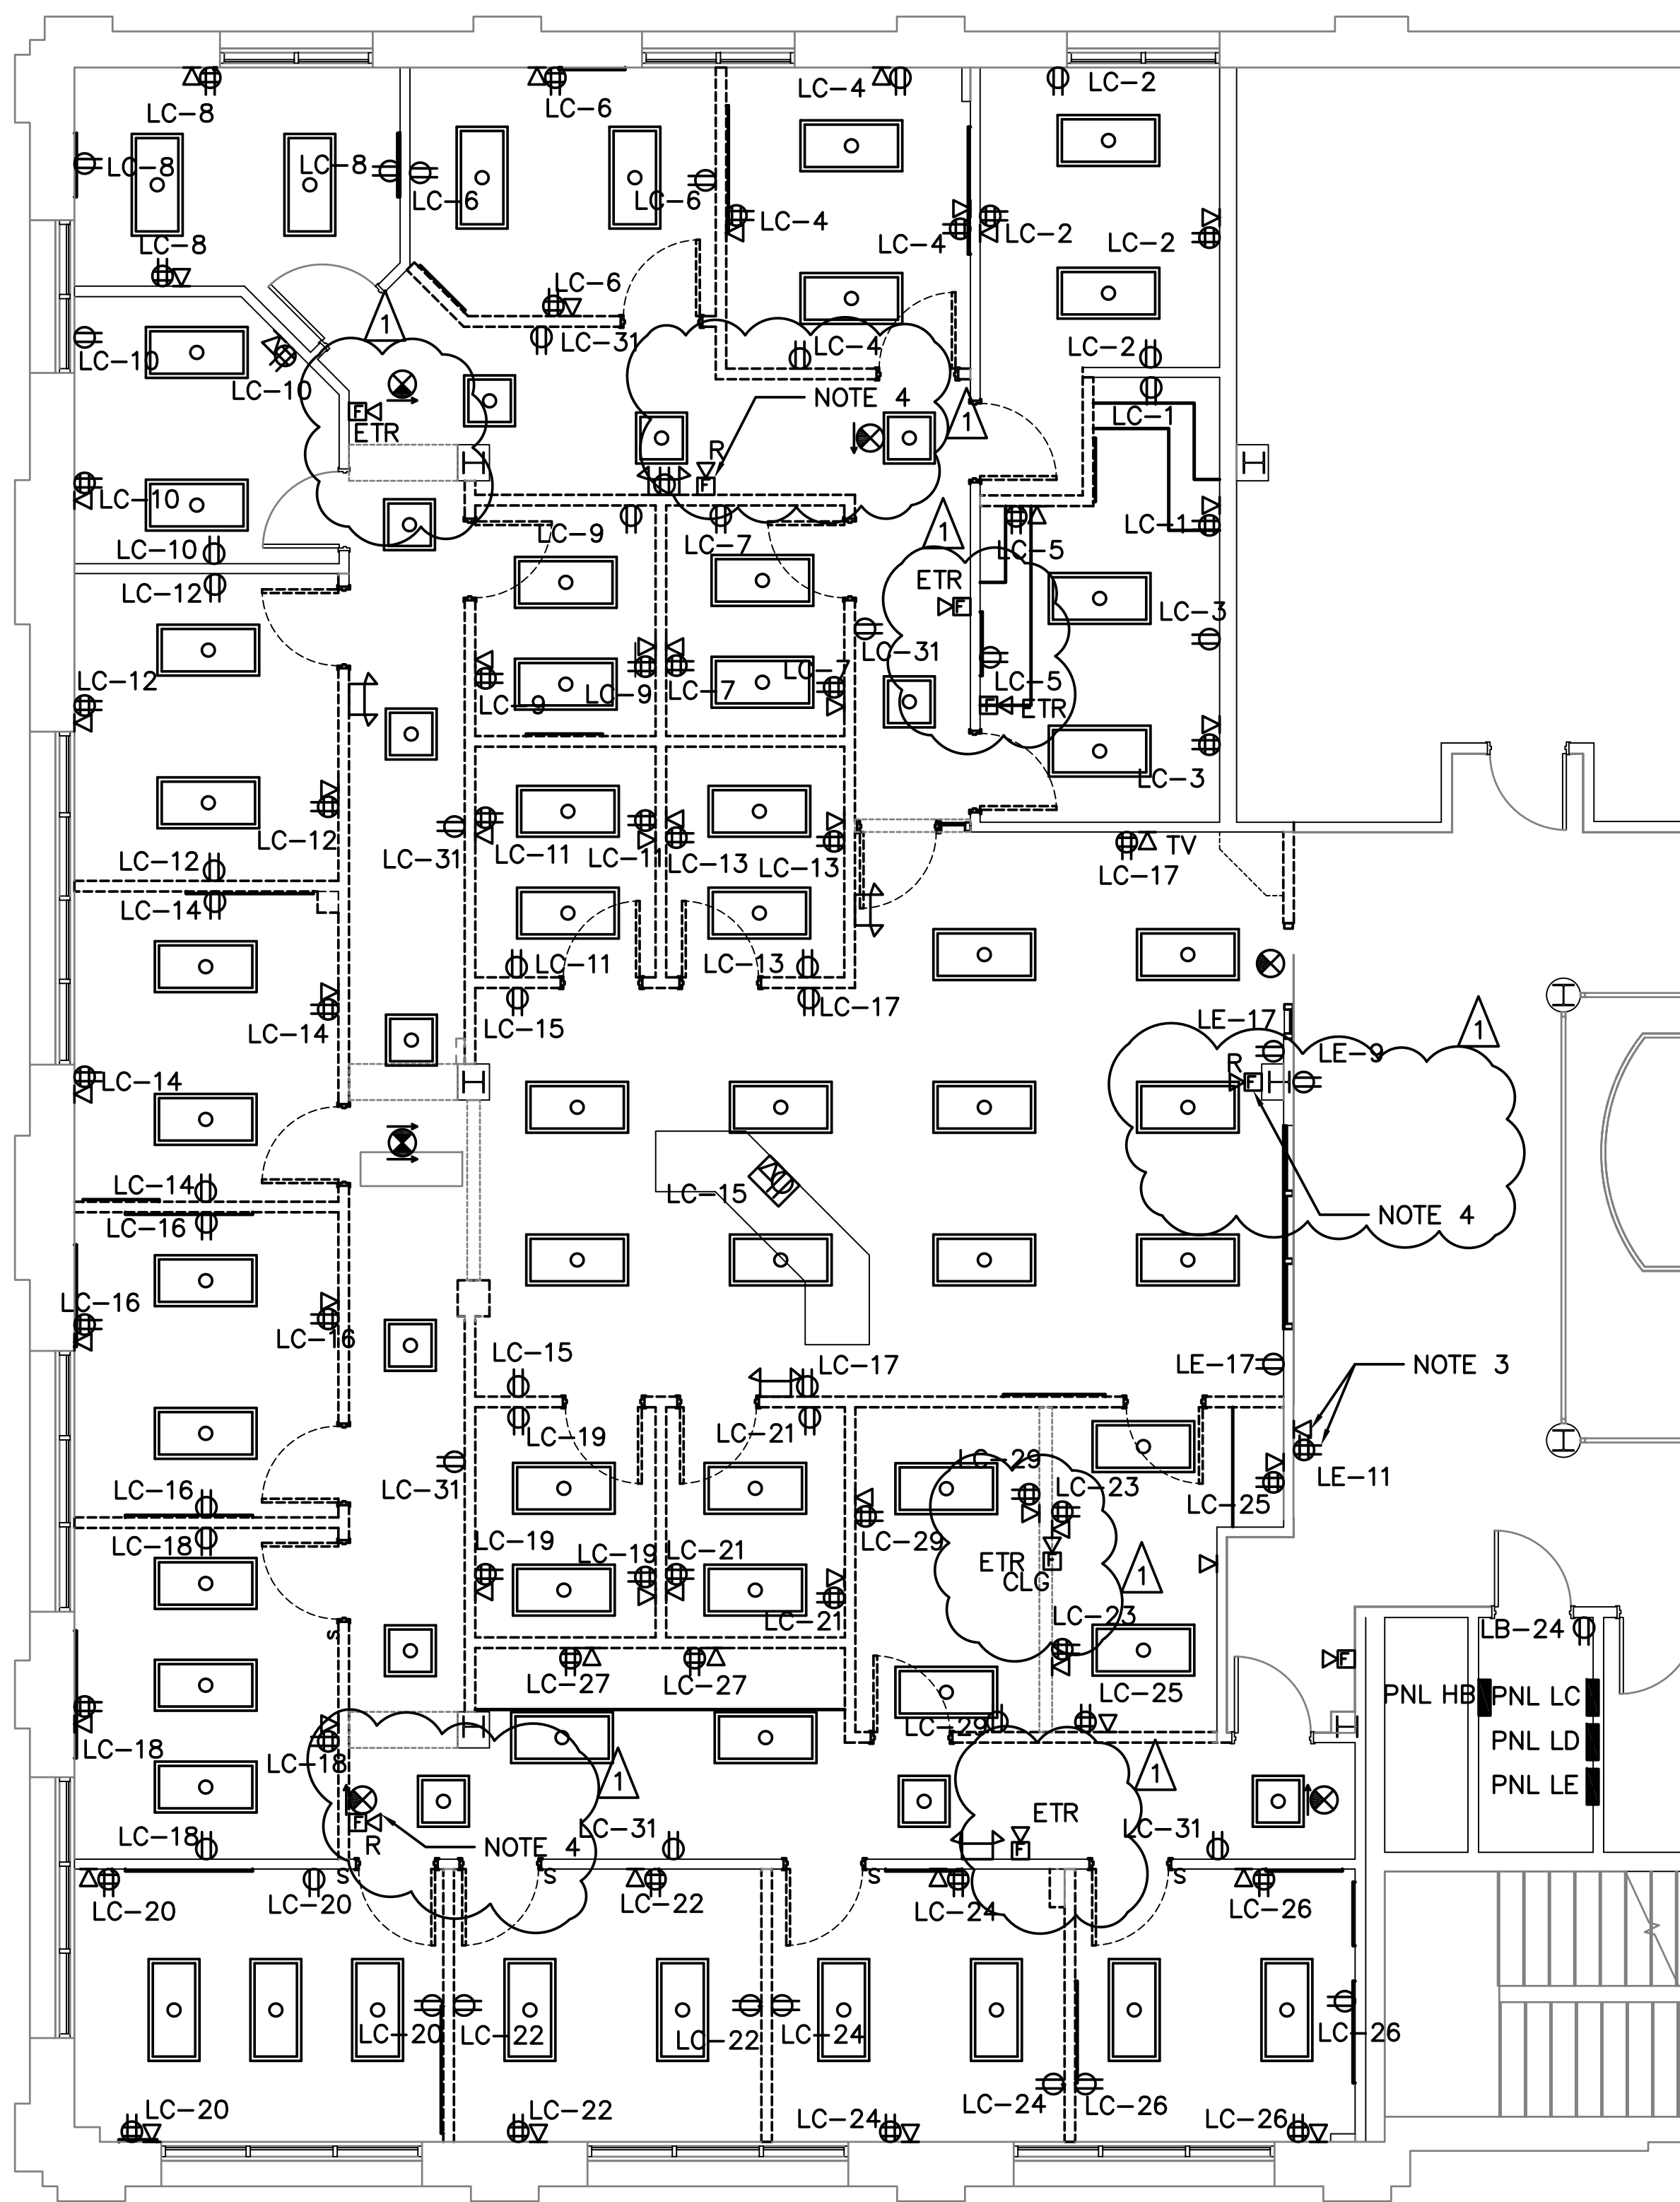

SECOND FLOOR DEMOLITION PLAN

3/16" = 1'-0"

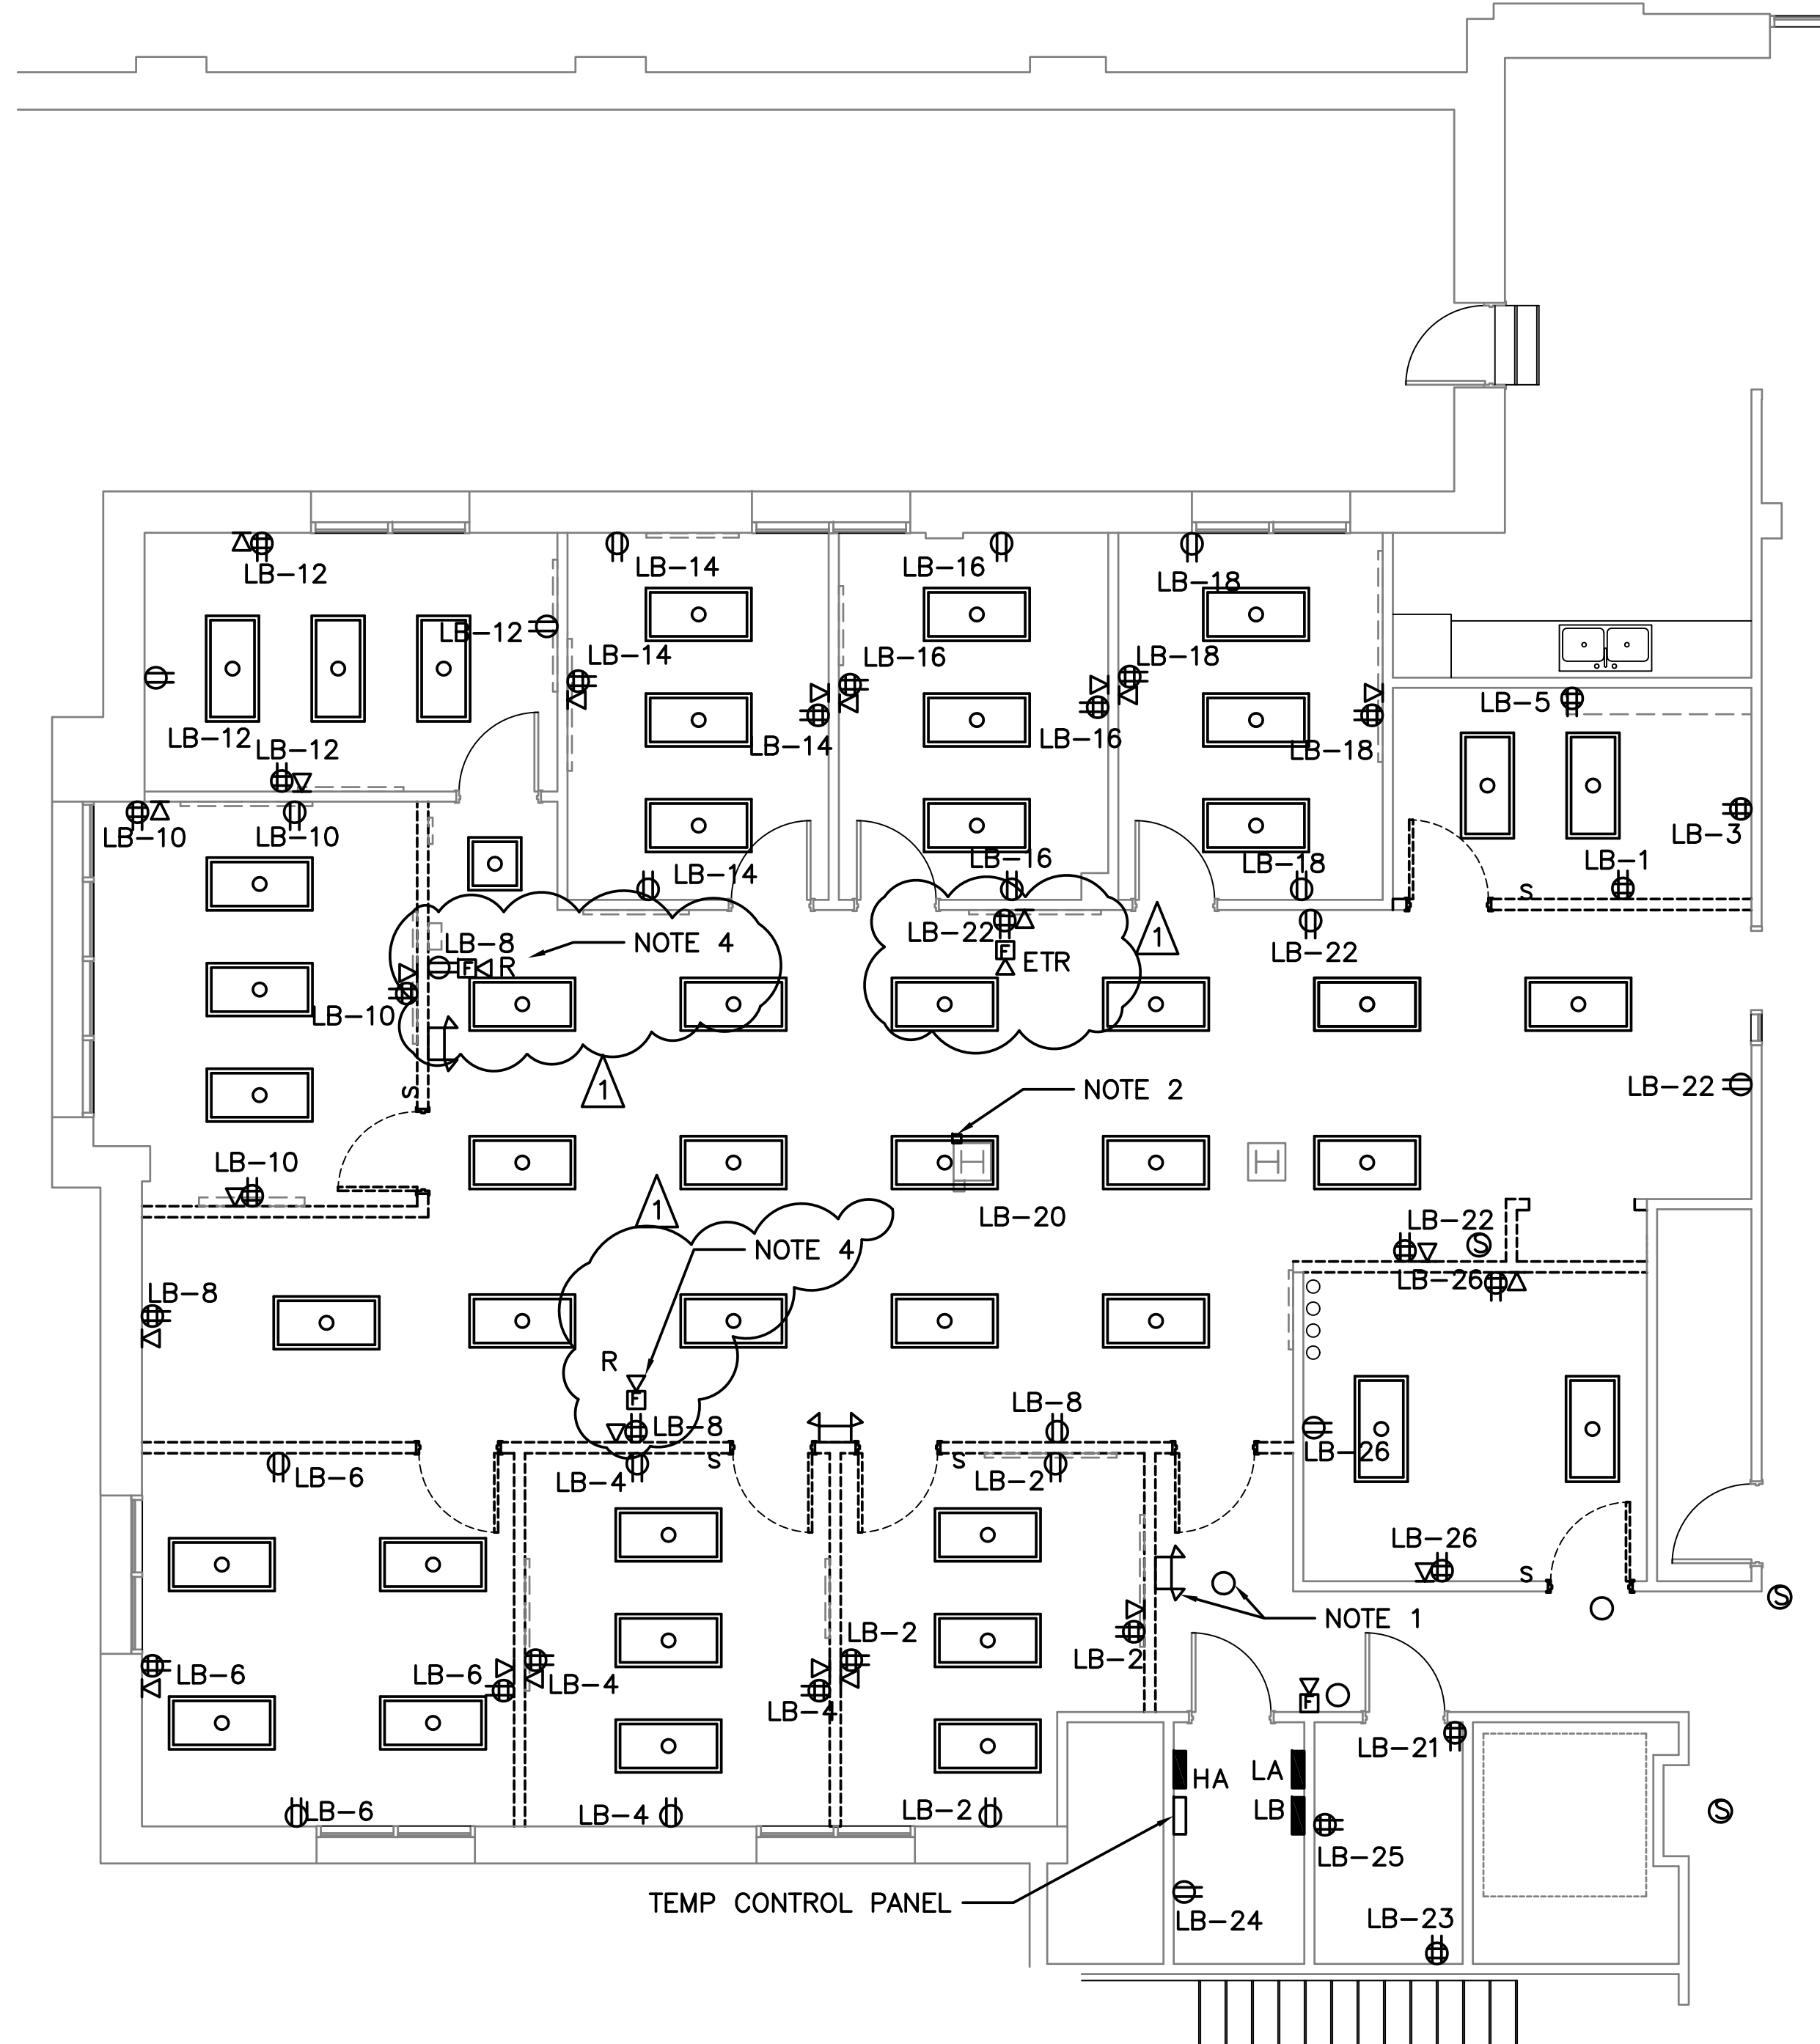

THIRD FLOOR DEMOLITION PLAN

3/16" = 1'-0"


NOTES THIS SHEET:

- EXISTING LIGHT FIXTURE TO BE RELOCATED. SEE SHEET E301 FOR NEW LOCATION.
- EXISTING POWER POLE TO BE RELOCATED. SEE SHEET E401 FOR NEW LOCATION.
- REMOVE, SALVAGE, AND REINSTALL EXISTING RECEPTACLE AND DATA. EXACT LOCATION SHALL BE COORDINATED WITH THE UNIVERSITY RENOVATIONS PM.
- RELOCATE EXISTING FIRE ALARM DEVICES TO NEW LOCATION. SEE NEW WORK FOR RELOCATED DEVICES.

GENERAL DEMOLITION NOTES:

- REMOVE EXISTING LIGHTING AND CONTROLS. RETAIN EXISTING CIRCUIT FOR RECONNECTION OF NEW LIGHTS ON EXISTING CIRCUITS. SEE NEW WORK PLAN FOR NEW LIGHTS.
- RECONFIGURE EXISTING POWER CIRCUITS TO FEED NEW FURNITURE. REUSE EXISTING CIRCUITS IN EACH AREA. SEE NEW WORK PLAN FOR NEW LAYOUT.
- SEE EXISTING FIRE ALARM DEVICES TO SEE IF DEVICES ARE 'ETR' - EXISTING TO REMAIN OR 'R' - RELOCATED, WITH NEW WORK. RELOCATE EXISTING DEVICES AND EXTEND CIRCUITS AS REQUIRED WITH FIRE ALARM SYSTEM. SEE NEW WORK FOR NEW DEVICES.


UBO APPROVAL

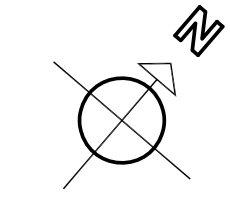

DATE: APR 10 2026
COMM No: 25-11
DRAWN BY:
CHECKED BY:
STATE PROJECT No:

2ND AND 3RD FLOOR DEMOLITION PLAN


RENOVATION OF 2ND AND 3RD FLOOR USFA SUITES
BLACKSBURG, VA

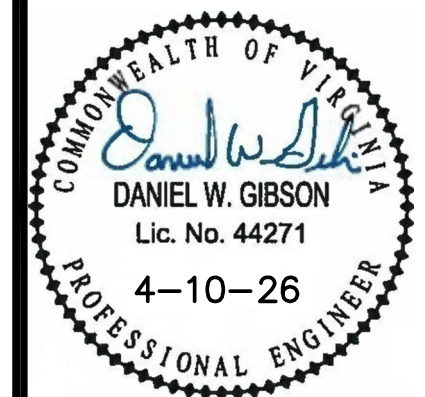

5 Design, LLC
20 Midway Plaza Dr, Suite 300
Christiansburg, VA 24073
540-230-2619
www.5designarchitecture.com


REVISIONS	DATE
DESCRIPTION	5/13/26
FIRE ALARM	
No.	1

EXHIBIT B
Second and Third Floor Lighting Plans

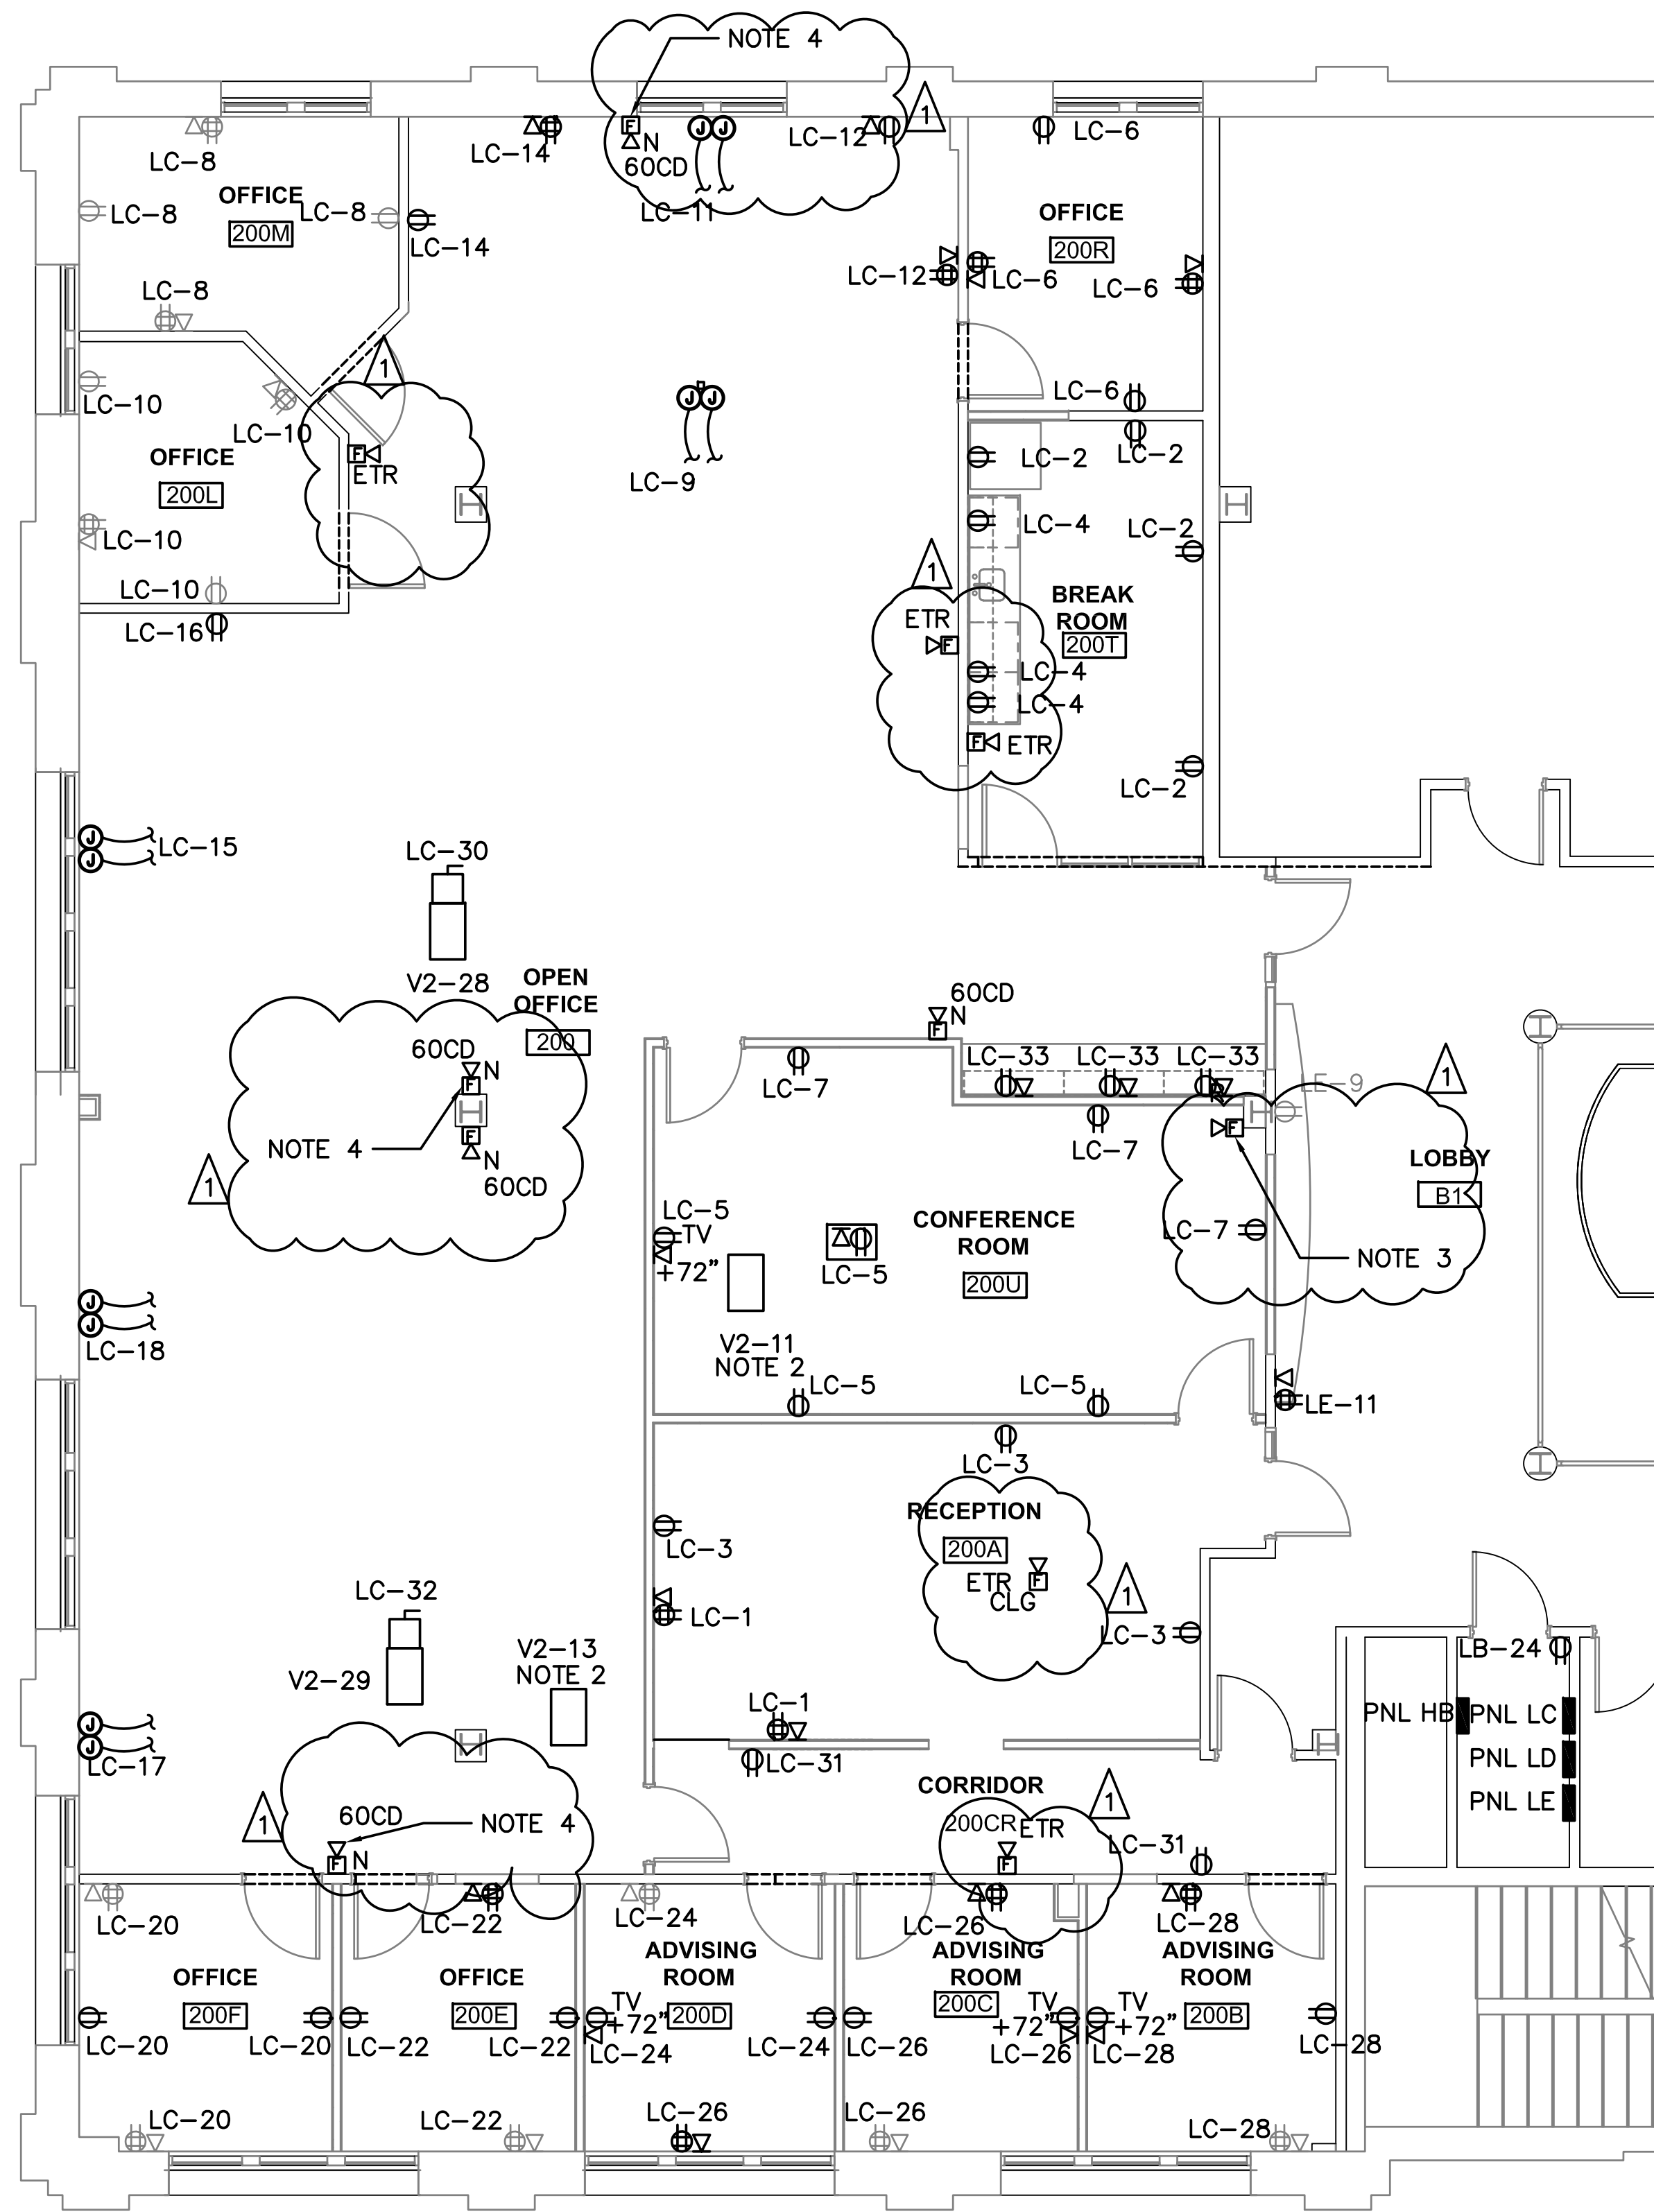

SECOND FLOOR POWER AND DATA PLAN

3/16" = 1'-0"

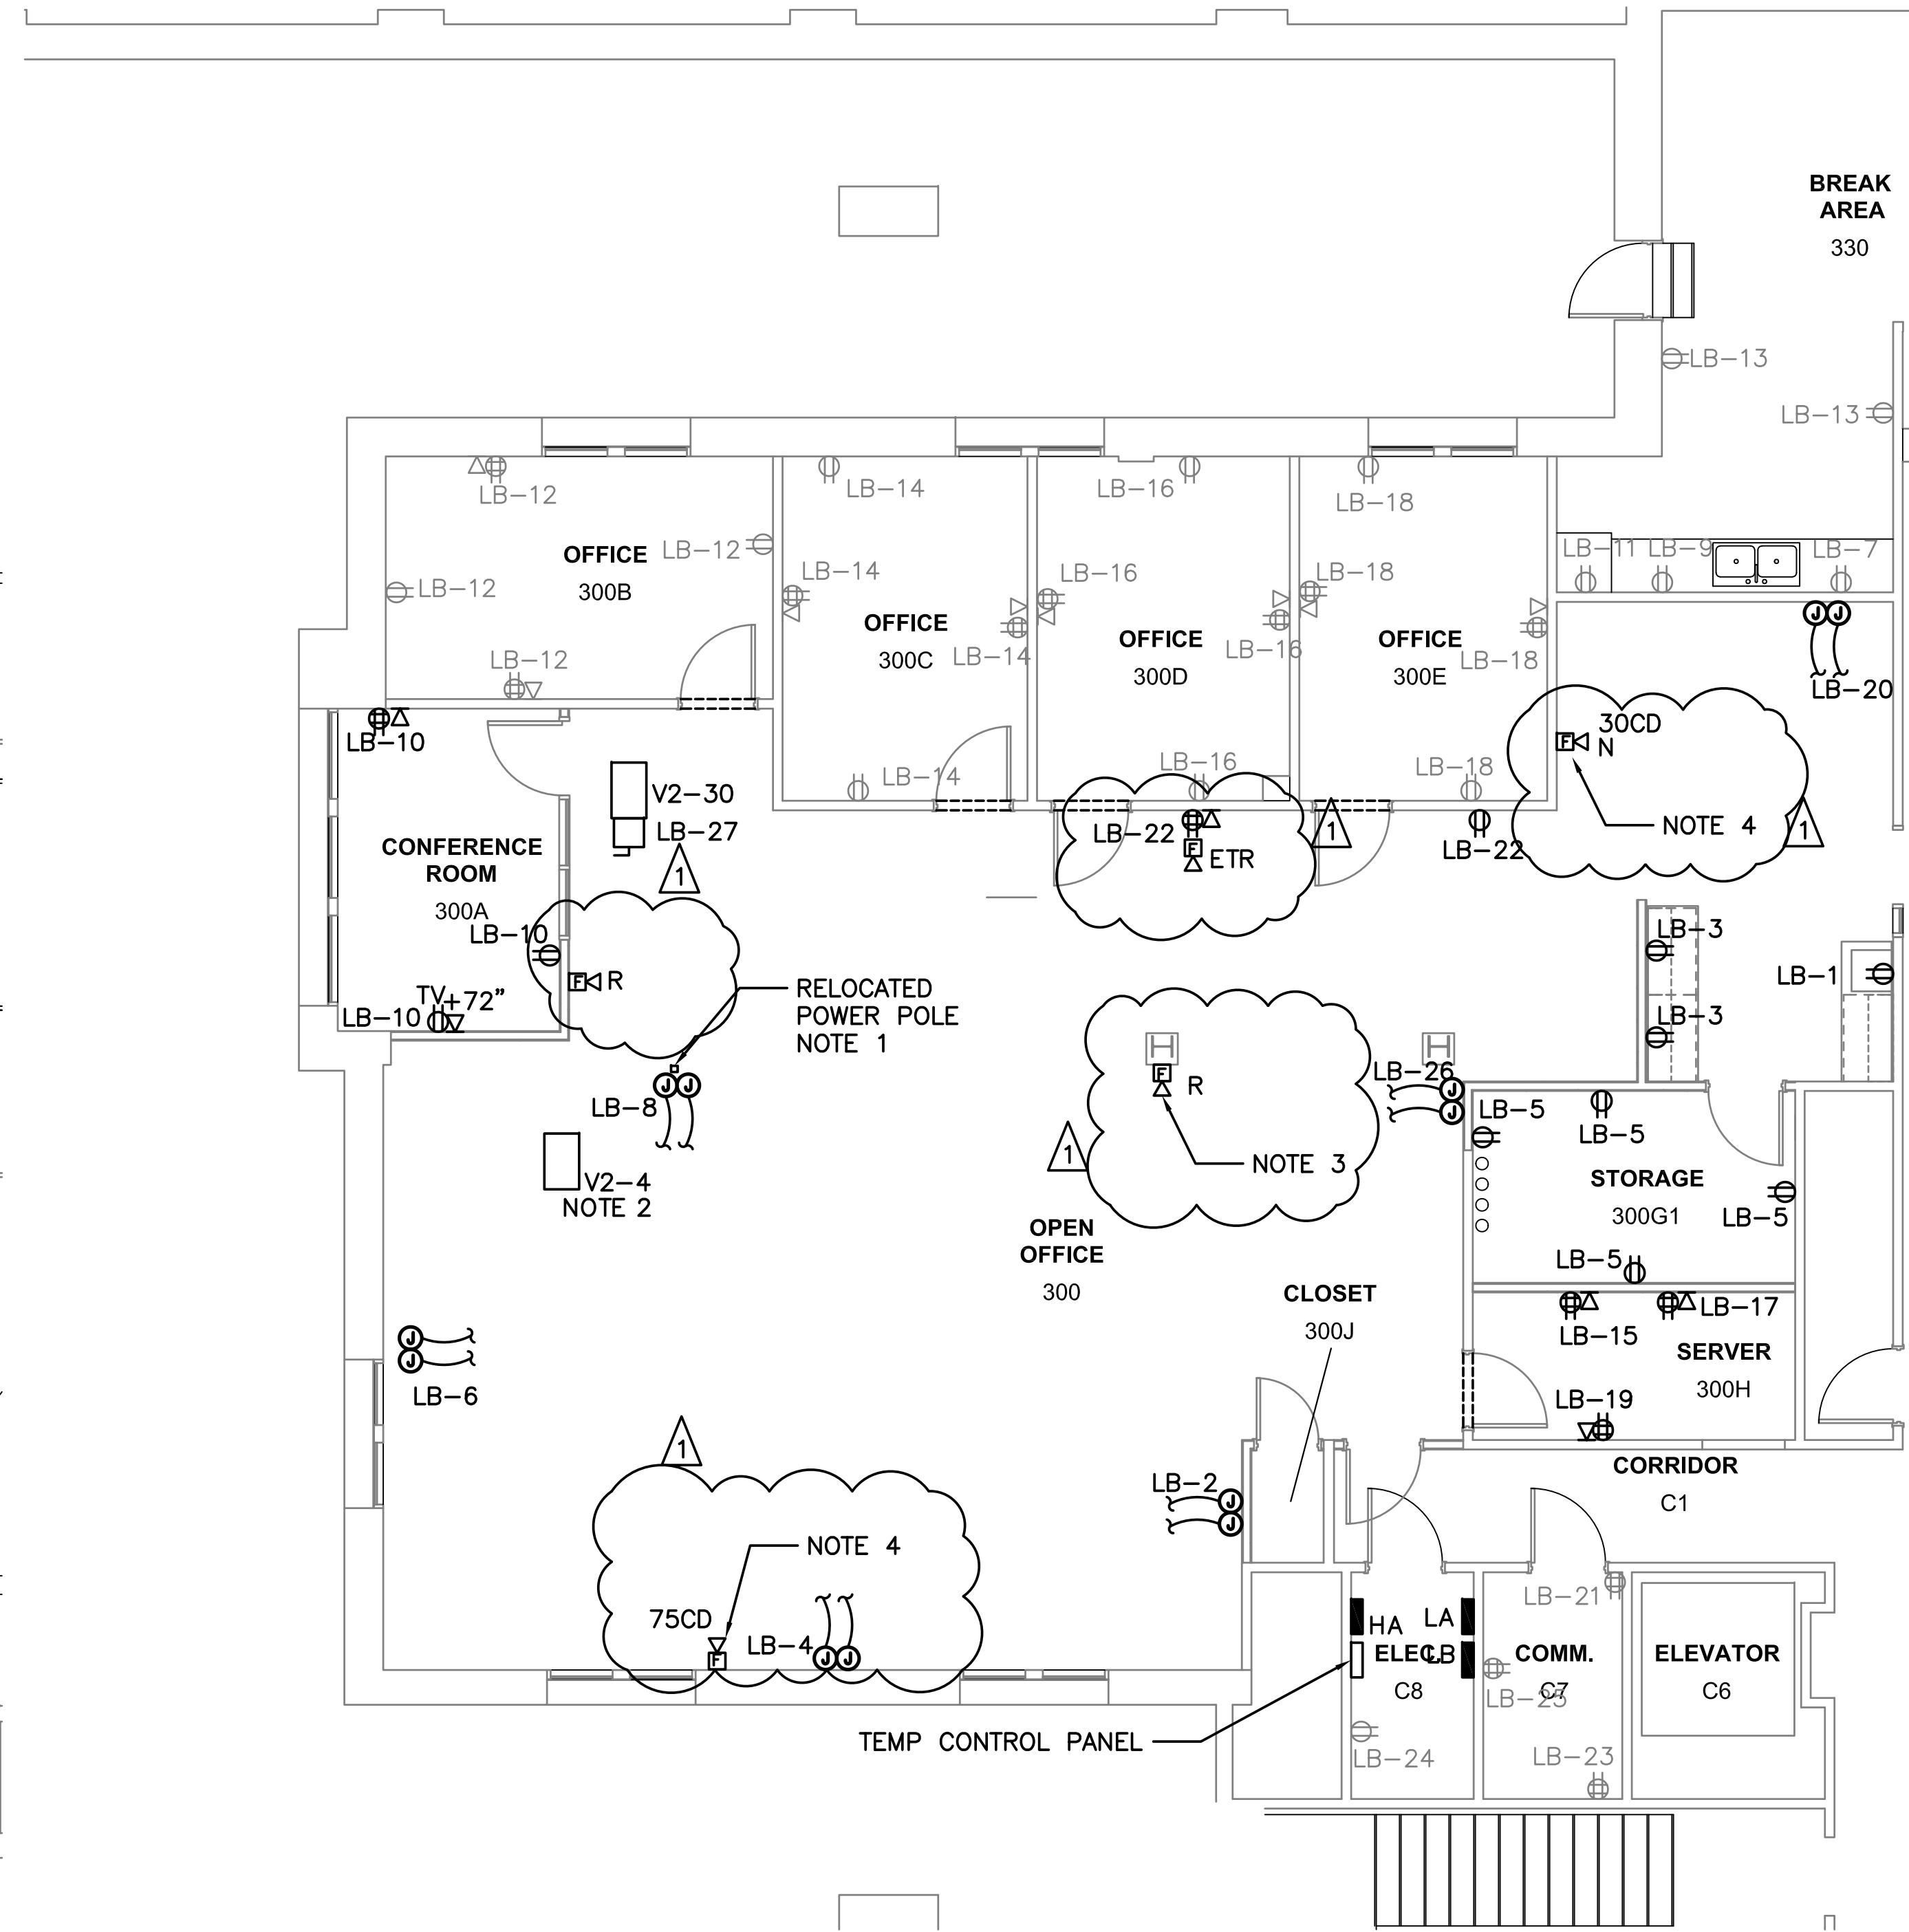


THIRD FLOOR POWER AND DATA PLAN

3/16" = 1'-0"

NOTES THIS SHEET:

1. RELOCATED EXISTING POWER POLE.
2. CONNECT REPLACEMENT UNIT TO EXISTING CIRCUIT.
3. RELOCATE EXISTING FIRE ALARM DEVICES IN THIS AREA TO NEW LOCATION. EXTEND EXISTING WIRING AS REQUIRED.
4. PROVIDE NEW FIRE ALARM DEVICE INDICATED. EXTEND EXISTING CIRCUIT AS REQUIRED. PROVIDE NEW FIRE ALARM BATTERY CALCULATIONS FOR NEW SHOP DRAWINGS.


UBO APPROVAL

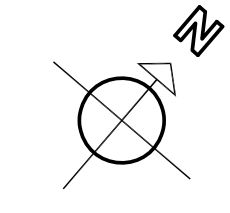

DATE:	APR 10 2026
COMM No.:	25-11
DRAWN BY:	
CHECKED BY:	
STATE PROJECT No.:	

2ND AND 3RD FLOOR LIGHTING PLAN

RENOVATION OF 2ND AND 3RD FLOOR USFA SUITES
BLACKSBURG, VA

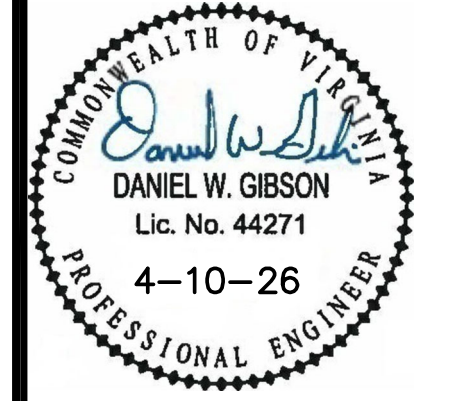

5 Design, LLC
20 Midway Plaza Dr, Suite 300
Christiansburg, VA 24073
540-230-2619
www.5designarchitecture.com

REVISIONS	DATE
DESCRIPTION	5/13/26
FIRE ALARM	
No.	1 2 3 4

E401