



VIRGINIA POLYTECHNIC INSTITUTE AND STATE UNIVERSITY
PROCUREMENT DEPARTMENT

ADDENDUM NO. 5

DATE: June 5, 2026
TO: All Offerors
FROM: Kim Widrig, Contracting Officer
TOTAL PAGE(S): 6 pages (not including attachments)
SOLICITATION TITLE: Improve Center Woods Complex
SOLICITATION NUMBER: 049302624

I. CLARIFICATIONS AND ADDITIONAL INFORMATION

1. Drawing Updates:

Modified sheets included in addendum: C201, E201, E702, E901, E902 (Attached as **Exhibit A**)

Description of drawing changes:

Electrical Changes (E)

E1: Reissued sheet E901 as it was erroneously omitted from Addendum #3.

E2: Reissued sheet E902 as it was erroneously omitted from Addendum #3.

E3: Added 120V connections for motorized shades in Meeting 1 103 and Meeting 2 117. Refer to sheets E201 and E702.

II. REQUESTS FOR INFORMATION

1. 123553.13: 2.3A Casework Construction indicates full flush overlay w/ wood fronts. Per the Lab Casework Legend, all casework with tagging that starts w/ #7 is to be inset design and door/drawer fronts are to be wood unless 'MF' suffix is shown in tag. There are several areas where inset and wood fronts are indicated. Inset wood fronts is not a configuration we typically see for lab casework and it can be a cost adder per cabinet. With the exception of specialty cabinets (e.g. flammable), please confirm if ALL casework is to be overlay design and if we are to refer to tagging for metal fronts vs. wood fronts.

Virginia Tech Response: *ALL typical wall/base/tall cabinets to be flush overlay. Specialty cabinets per mnfr standard specifications. Typical Base cabinets and Tall cabinets to be wood fronts with metal body. All wall cabinets to be metal body and front. Disregard schedule finish conflicts.*

2. There is conflicting information between documents as it relates to worksurface material. Please confirm tops are to be Fundermax Phenolic per 123553.13 spec. and not epoxy.

Virginia Tech Response: *Typical lab worksurfaces to be Phenolic as indicated in specifications; not epoxy. Where indicated, provide stainless steel or wood.*

3. Please confirm (L-05) wall shelving is to be painted steel and not epoxy as noted on Lab Equipment Schedule. If not painted steel, we would phenolic be acceptable in lieu of epoxy to match worksurfaces?

Virginia Tech Response: *Provide phenolic shelf material (match countertops).*

4. Please confirm (EQ-05) Flammable Cabinets are to be provided by Lab Casework scope per Equipment Schedule and not the Owner as indicated on A102 Architectural Plan Notes.

Virginia Tech Response: *Flammables Cabinets will be CFCI, as listed in Lab Equipment Schedule. Note on A102 is incorrect.*

5. Please confirm who is to provide the Ice Machine in Shop Fab / A717. Did not see it listed in Equipment Schedule. Additionally, if there is a BOD, please provide that make/model information.

Virginia Tech Response: *Ice Maker to be CFCI. BOD is **Empura E-MCFB350 Air-Cooled Cube-Style with Bin.***

6. Please provide a model/manufacture for the L-03 Metal Pegboards.

Virginia Tech Response: *Provide Steel System by Uline (incl Starter Kit) or similar - design intent is a universal system, easy for owner to provide new parts in the future as needed.*

7. Please confirm if 123553-2.4E: Are these toolbars + accessories required or is this section N/A? None shown on drawings.

Virginia Tech Response: *Provide as indicated in specifications.*

8. Please confirm the requirements for base cabinets under the fume hoods, or if tables/stands are preferred as the elevation suggests (e.g. E1/A714).

Virginia Tech Response: *Fume hoods shall be provided with acid storage cabinets underneath.*

9. Confirm standard 22"D base cabinets in lieu of 22.5"D, and standard widths (e.g. 30"W ilo 29"W, 42"W ilo 41"W, etc.) are acceptable adjustments to the dimensions noted on the Equipment Schedule.

Virginia Tech Response: *Manufacturer standard depths and widths are acceptable.*

10. Smoked Glass windows are listed in the specs for the casework. Please confirm this is required as it is a custom item

Virginia Tech Response: *Standard clear glass is acceptable.*

11. Regarding site access, will we be able to deliver with 53' trucks or should we account for short "PUP" trucks.

Virginia Tech Response: *We do not intend to restrict delivery truck sizes - that will be up to the contractor/vendors. The road was cleaned up some during conversations with the Fire Marshal to ensure fire trucks could use the road, but we did not model semis entering the site and turning around.*

12. Specs list a mockup requirement with specific details, but “as indicated on the shop drawings”. We could not find any mock up details in the shop drawings. Please confirm any mockup requirements we should account for.

Virginia Tech Response: *No mockups are required for lab casework or fume hoods.*

13. Please confirm who is to provide the D3/A715 & D4/A715 Animal Sink and Base. Assuming Lab Casework would provide galvanized steel base shown in grey and plumbers provide the sink unit its self shown in white with piping?

Virginia Tech Response: *Sink (S1 on P-500) to be provided by plumbing subcontractor. Support frame was designed as a custom metal fabrication, but can be provided as a custom frame by another trade if it can suitably support the vitreous sink. The purpose of the frame is to prevent heavy loads from causing the sink to pull away from the wall.*

14. Please confirm (L-04) Metal Lockers are by Others/Div10 and not part of Lab Casework Scope of Work.

Virginia Tech Response: *Confirmed.*

15. Please confirm (L-03) Metal Pegboards w/ Hook Kits are within the Lab Casework Scope of Work. Additionally, if there is a BOD, please provide that make/model information.

Virginia Tech Response: *L-03 may be provided by Lab Casework supplier or another trade as appropriate. See Line 8 for BOD.*

16. Please confirm if Safety Stations are to be provided by Lab Casework with TMVs and installation by Plumber, or if the Plumber will provide the full assembly.

Virginia Tech Response: *No preference for which subcontractor will provide and/or install the Safety Stations. This is GC Means and Methods.*

17. Please confirm we are to include (3) shared Overhead Ceiling Panels to accommodate the pre-wired electrical on the T-02A Moveable Benches. Please also confirm that Lab Casework is to provide cutouts only w/ back-boxes, devices, and cover plates by Others/Electrical team.

Virginia Tech Response: *Benches are powered from the wall, not overhead. Yes - lab casework to provide cutouts only.*

18. Please confirm if Lab Casework scope is responsible for installing the E-03, E-06, E-07, and E-08 OFCI items listed on the Lab Equipment Schedule or if this will be the responsibility of other trades.

Virginia Tech Response: *The items listed are all OFCI. Installation responsibility is means and methods; up to the Contractor.*

19. Please confirm that the concrete foundation walls will have exposed aggregate at locations called out by note 21 on sheets A201 and A202.

Virginia Tech Response: *Note 21 on A201/202 is incorrect. Please provide a smooth formwork finish for all exposed foundation wall concrete.*

20. On S111, along grid line 6 three WC-1 columns are called out. WC-1 per S004 is a 12x12 timber column. Sheet A102 calls out the same columns per note 13 as glulam columns. Please clarify material type for the columns.

Virginia Tech Response: *WC-1 is a 12x12 timber column.*

21. Sheet C201 is referenced in note C4 of Addendum 3 but the revised sheet was not included in the addendum. Please provide revised C201.

Virginia Tech Response: *Sheet was erroneously omitted from Addendum #3. Sheet C201 is attached herein in **Exhibit A**.*

22. Sheet E901 is referenced in notes E1 and E3 of Addendum 3 but the revised sheet was not included in the addendum. Please provide revised E901.

Virginia Tech Response: *Sheet was erroneously omitted from Addendum #3. Sheet E901 is attached herein in **Exhibit A**.*

23. Sheet E902 is referenced in note E3 of Addendum 3 but the revised sheet was not included in the addendum. Please provide revised E902.

Virginia Tech Response: *Sheet was erroneously omitted from Addendum #3. Sheet E902 is attached herein in **Exhibit A**.*

24. Sheet E301 is referenced in note E5 of Addendum 3 but the revised sheet was not included in the addendum. Please provide revised E301.

Virginia Tech Response: *Sheet was erroneously included Addendum #3 narrative - no change.*

25. Section 2.5D of specification 105143 for the wire mesh storage lockers calls for powder coat finish. Section 2.5A calls for galvanized. Please clarify the finish for the wire mesh storage lockers.

Virginia Tech Response: *Powder coat finish is acceptable. Provide manufacturer's standard color chart for color selection during submittals.*

26. Please specify the lock that should be used for wire mesh storage lockers. The 3'x3' storage cages can only use a padlock lug per Wirecrafters because these will not have post whereas the other units have multiple options. Please see the following link, <https://www.wirecrafters.com/products/components/standard-custom-locks/>

Virginia Tech Response: *Please provide padlock hasps for all doors - end user does not want to manage keys.*

27. In specification 122413, sections 2.2F, 2.3G, and 2.4G specify both front fascia and exposed headbox complete with top and back covers. Is front fascia alone acceptable, or must we include top and back covers?

Virginia Tech Response: *The intent is for exposed shade hardware to be fully enclosed. Contractor shall provide front fascia, top cover, and back cover where required to achieve a complete exposed headbox assembly.*

28. In specification 122413, section 2.3 A3 specifies EcoVeil 6009 which does not exist. Please clarify BOD.

Virginia Tech Response: *Provide EcoVeil Series - full range of colors. Product # aligns to openness %. See specifications.*

29. In specification 122413, section 2.3 B3 specifies both keyed and toggle switches. Where is each required?

Virginia Tech Response: *Shade controls in Large Meeting Hall intended to be connected to a wall mounted control panel (by others). Toggles and key switches are not required.*

30. In specification 122413, section 2.3 B3e specifies Sun Sensors. Where is this required?

Virginia Tech Response: *Disregard. Not in Scope.*

31. In specification 122413, section 2.3 B3g specifies Timer Control. Where is this required?

Virginia Tech Response: *Disregard. Not in Scope.*

32. In specification 122413, section 2.3 B4 specifies Crank-Operator Override. This is not offered by most manufacturers. May we exclude?

Virginia Tech Response: *Yes. Please exclude.*

33. In specification 122413, section 2.3 B6 specifies Interface with AV and "Accepting input from BACS." Is this required? May we include dry contact, and exclude RS232, BACnet, PoE?

Virginia Tech Response: *Please provide RS232 interface to allow independent control of both layers of shades in the Large Meeting Room only.*

34. In specification 122413, section 2.3.G.4. specifies, "Recessed Shade Pocket." None designated. May we exclude?

Virginia Tech Response: *Yes. Please exclude.*

35. In specification 122413, sections a. 2.3.G.6.-7., 2.4.G.5.-6. specify, "Side/sill channels." May we exclude side/sill channels with light-filtering shades? May we exclude side/sill channels with light-blocking shades?

Virginia Tech Response: *Yes, exclude side channels where shades are only light filtering. Where shades include light-blocking, provide channels.*

36. In specification 122413, sections a. 2.5.B.2. specifies, "PVC-coated fiberglass" and "5% openness." "Basis of Design Finish Legend, 122413, EcoVeil" is PVC-free and scheduled as "3% openness." Which fabric "Type" is required? Which "openness" is required?

Virginia Tech Response: *Please refer to Line 30 for this information.*

37. Details on D6 and E6 on A501, single shades are shown and dual shades are noted. Please clarify intent.

Virginia Tech Response: *Dual shades are required in Large Meeting Hall and each Meeting Room (2ea) - single layer shades are acceptable in all other locations.*


38. The Finish Schedule notes 6 and 7 specify which room receive shades. In those rooms, can we exclude shades at doors, door transoms, door sidelites, and interior glazing?

Virginia Tech Response: *Provide shades at exterior openings only; no interior doors, glazing etc. require shades.*


39. On E201, <EP46> is not shown at [103, 117]. Please clarify and coordinate to eliminate scope gap.

Virginia Tech Response: *Connections and associated notes have been added to account for meeting room motorized shades. Sheet E201 is attached herein in **Exhibit A**.*


EXHIBIT A
Revised Sheets

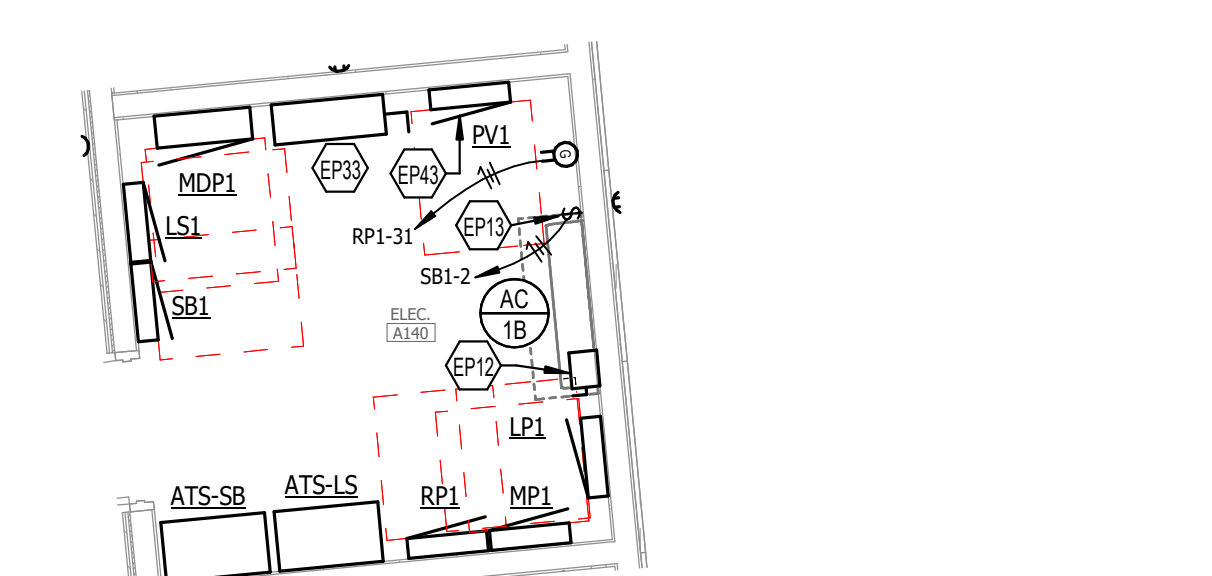


2 ENLARGED POWER FLOOR PLAN - ELEC A140
1/4" = 1'-0" 1/4" = 1'-0"

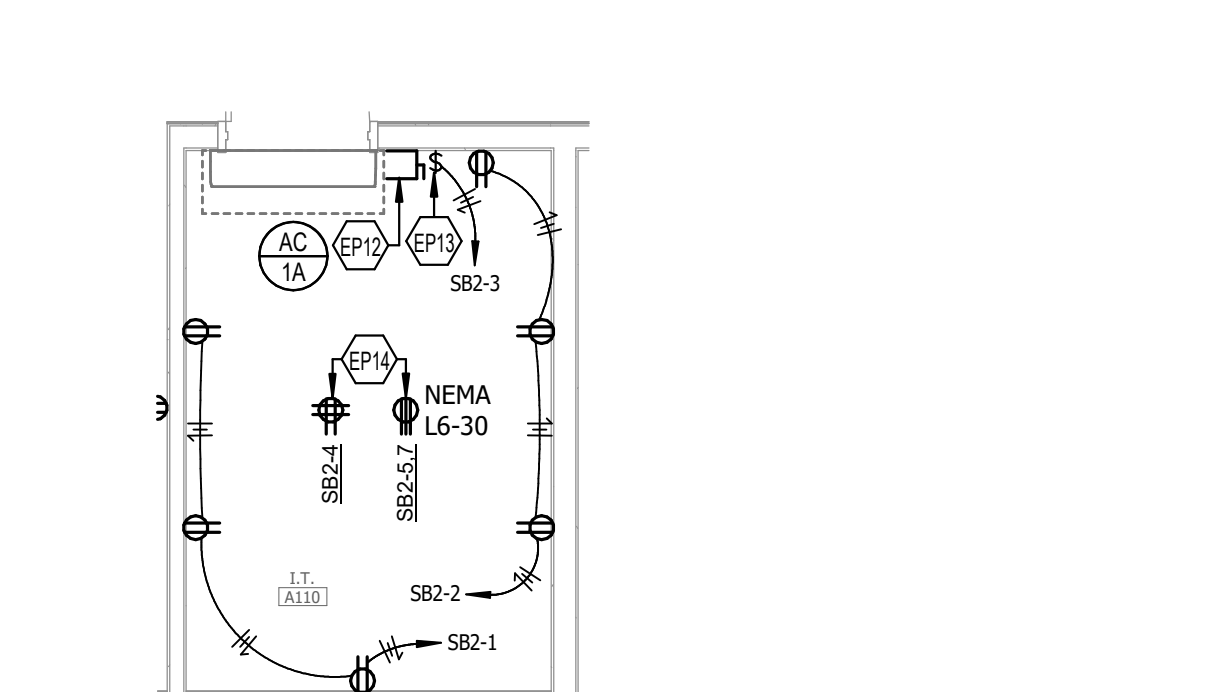

5 ENLARGED POWER FLOOR PLAN - I.T. A110
1/4" = 1'-0" 1/4" = 1'-0"

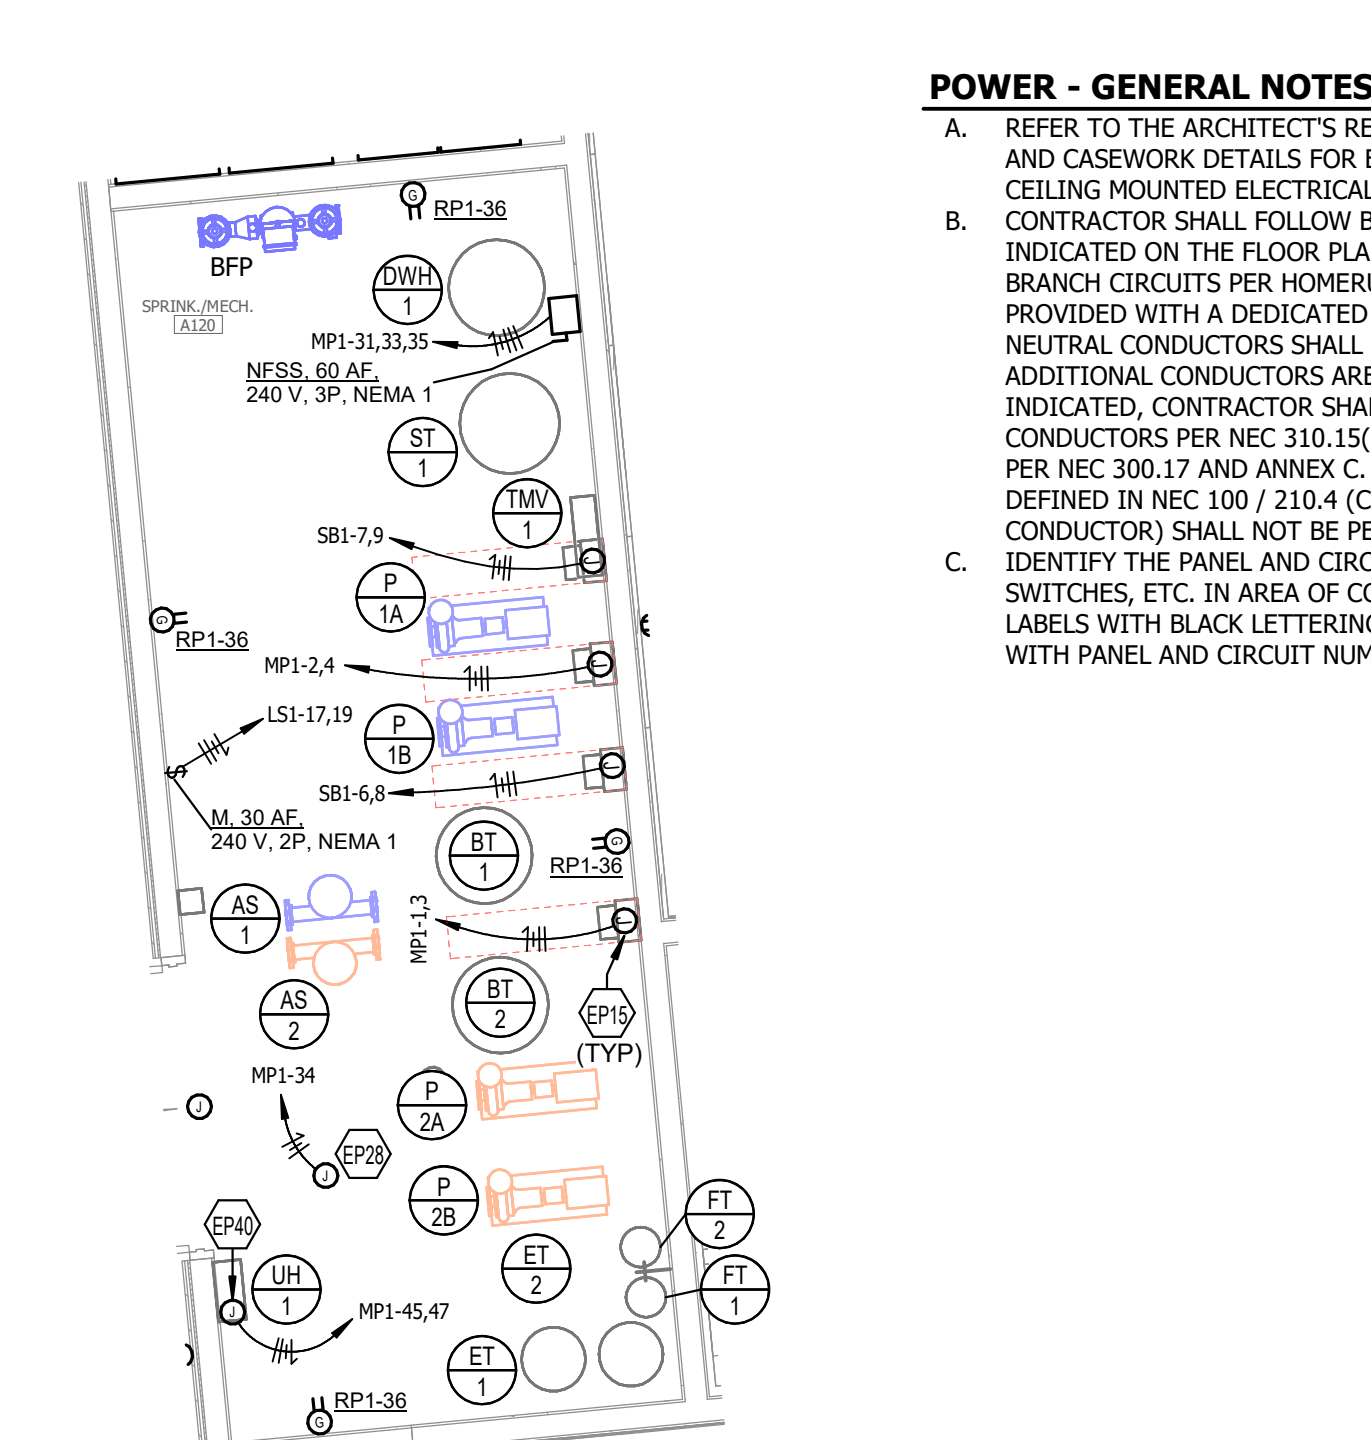

3 ENLARGED POWER FLOOR PLAN - SPRINK./MECH. A120
1/4" = 1'-0" 1/4" = 1'-0"

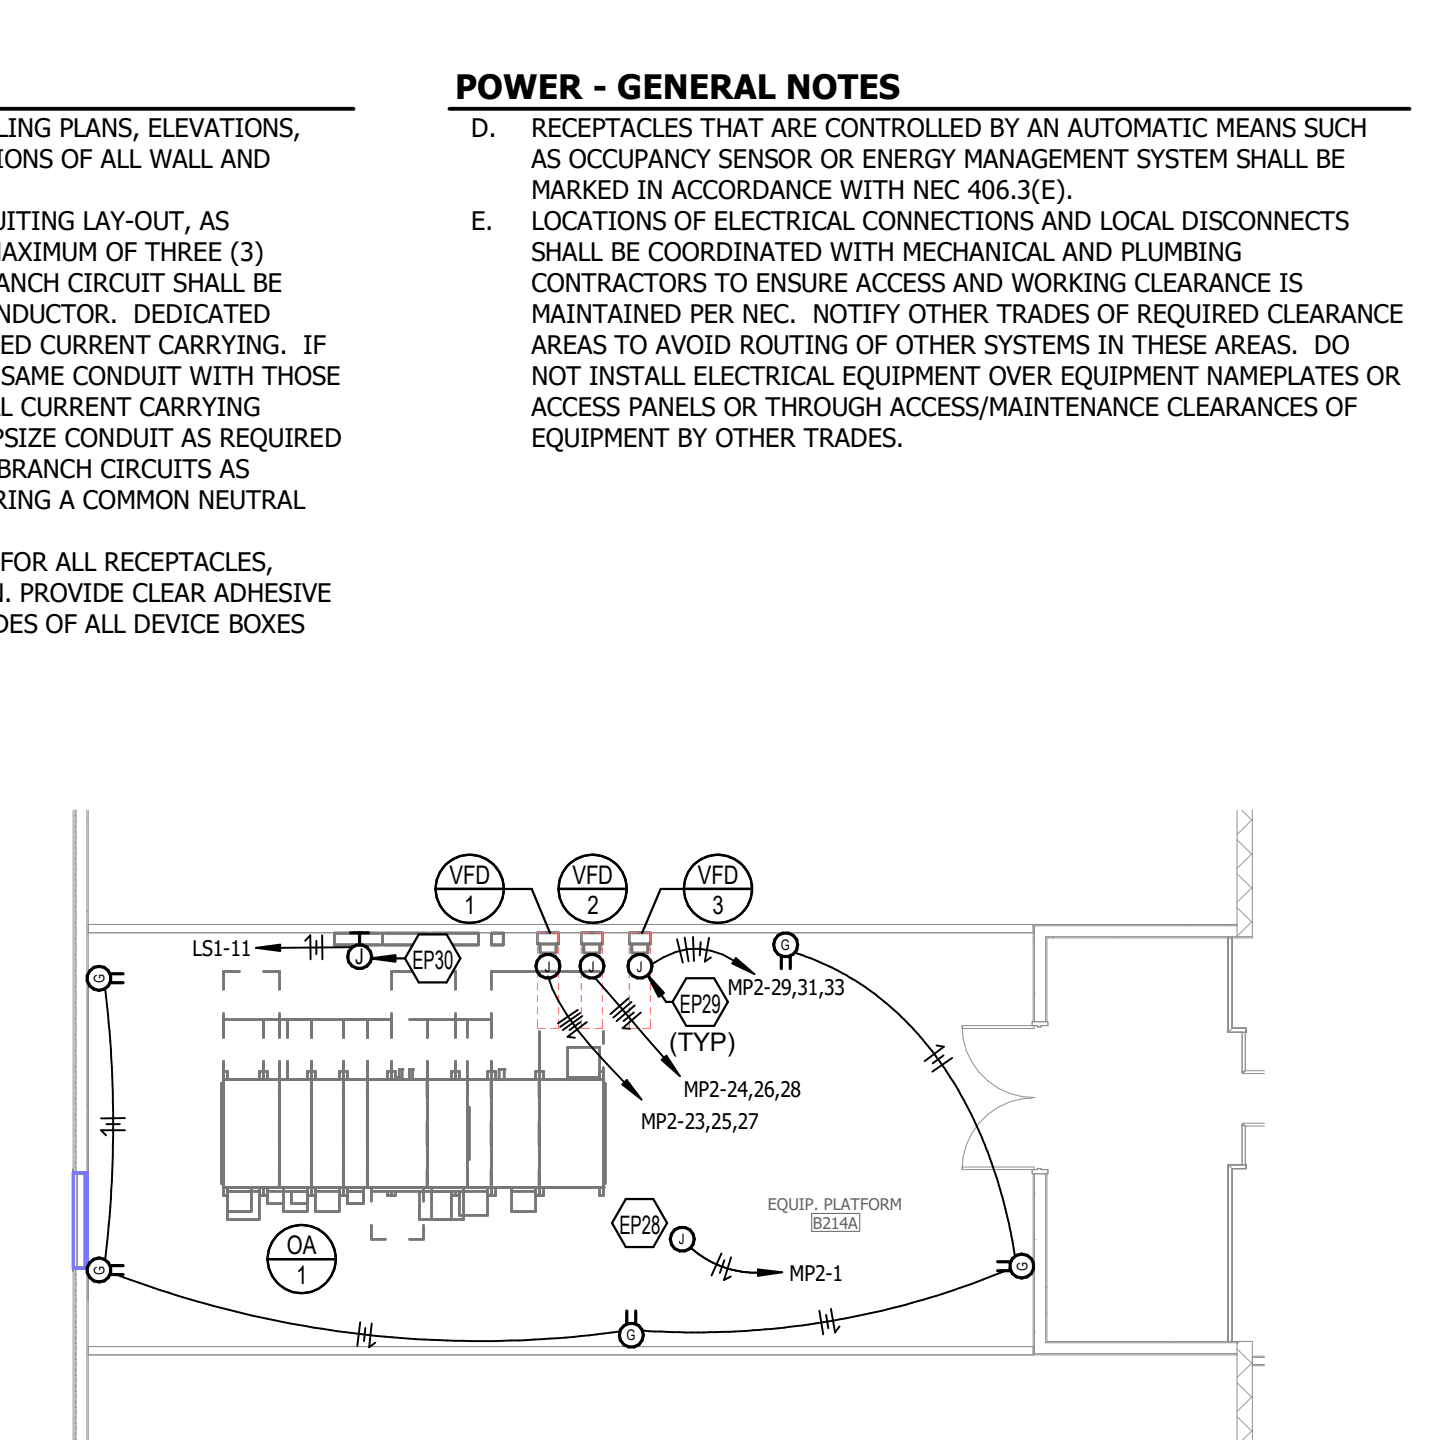

4 ELECTRICAL POWER FLOOR PLAN - MECHANICAL PLATFORM
1/8" = 1'-0" 1/8" = 1'-0"

POWER - GENERAL NOTES

A. REFER TO THE ARCHITECT'S REFLECTED CEILING PLANS, ELEVATIONS, AND CASEWORK DETAILS FOR EXACT LOCATIONS OF ALL WALL AND CEILING MOUNTED ELECTRICAL DEVICES.

B. CONTRACTOR SHALL FOLLOW BRANCH CIRCUITING LAY-OUT, AS INDICATED ON THE FLOOR PLANS, WITH A MAXIMUM OF THREE (3) BRANCH CIRCUITS PER HOMERUN. EACH BRANCH CIRCUIT SHALL BE PROVIDED WITH A DEDICATED NEUTRAL CONDUCTOR. DEDICATED NEUTRAL CONDUCTORS SHALL BE CONSIDERED CURRENT CARRYING. IF ADDITIONAL CONDUCTORS ARE RUN IN THE SAME CONDUIT WITH THOSE INDICATED, CONTRACTOR SHALL DEBATE ALL CURRENT CARRYING CONDUCTORS PER NEC 310.15(B)(3), AND UPSIZE CONDUIT AS REQUIRED PER NEC 300.17 AND ANNEX C. MULTIWIRE BRANCH CIRCUITS AS DEFINED IN NEC 100 / 210.4 (CIRCUITS SHARING A COMMON NEUTRAL CONDUCTOR) SHALL NOT BE PERMITTED.

C. IDENTIFY THE PANEL AND CIRCUIT NUMBER FOR ALL RECEPTACLES, SWITCHES, ETC. IN AREA OF CONSTRUCTION. PROVIDE CLEAR ADHESIVE LABELS WITH BLACK LETTERING. MARK INSIDES OF ALL DEVICE BOXES WITH PANEL AND CIRCUIT NUMBER.

POWER - GENERAL NOTES

D. RECEPTACLES THAT ARE CONTROLLED BY AN AUTOMATIC MEANS SUCH AS OCCUPANCY SENSOR OR ENERGY MANAGEMENT SYSTEM SHALL BE MARKED IN ACCORDANCE WITH NEC 406.3(E).

E. LOCATIONS OF ELECTRICAL CONNECTIONS AND LOCAL DISCONNECTS SHALL BE COORDINATED WITH MECHANICAL AND PLUMBING CONTRACTORS TO ENSURE ACCESS AND WORKING CLEARANCE IS MAINTAINED PER NEC. NOTIFY OTHER TRADES OF REQUIRED CLEARANCE AREAS TO AVOID ROUTING OF OTHER SYSTEMS IN THESE AREAS. DO NOT INSTALL ELECTRICAL EQUIPMENT OVER EQUIPMENT NAMEPLATES OR ACCESS PANELS OR THROUGH ACCESS/MAINTENANCE CLEARANCES OF EQUIPMENT BY OTHER TRADES.

TAGGED NOTES

EP01 PROVIDE CEILING-MOUNTED RECEPTACLE FOR SUSPENDED CORD REEL. PROVIDE HUBBELL HBL21523R220M1 (OR EQUIVALENT) AND MOUNT TO CEILING. COORDINATE FINAL LOCATION PRIOR TO INSTALL.

EP02 PROVIDE 120V CONNECTION FOR CIRCULATION FAN. INSTALL VENDOR-FURNISHED CONTROL STATION AND ROUTE CIRCUIT THROUGH CONTROL STATION TO TERMINATION POINT AT FAN MOTOR. COORDINATE FINAL LOCATION WITH MECHANICAL CONTRACTOR PRIOR TO INSTALL.

EP03 DUPLEX RECEPTACLE INTENDED TO SERVE COPIER. COORDINATE FINAL EQUIPMENT LOCATION PRIOR TO INSTALL.

EP10 PROVIDE 120V CONNECTION FOR HAND DRYER.

EP11 PROVIDE 120V CONNECTION FOR PAPER TOWEL DISPENSER. COORDINATE FINAL CONNECTION REQUIREMENTS WITH EQUIPMENT VENDOR PRIOR TO INSTALL.

EP12 PROVIDE 240V, 30A/2P, NEMA 1 RATED NON-FUSED DISCONNECT SWITCH FOR SPLIT SYSTEM INDOOR UNIT. EXTEND CIRCUIT FROM OUTDOOR SPLIT SYSTEM UNIT THROUGH DISCONNECT TO TERMINATION POINT AT INDOOR UNIT. COORDINATE FINAL LOCATION WITH MECHANICAL CONTRACTOR PRIOR TO INSTALL.

EP13 PROVIDE 120V, 20A/1P MOTOR-RATED SWITCH FOR SPLIT SYSTEM CONDENSATE PUMP. COORDINATE FINAL LOCATION WITH MECHANICAL CONTRACTOR PRIOR TO INSTALL.

EP14 PROVIDE RACK-MOUNTED RECEPTACLE. COORDINATE FINAL LOCATION AND MOUNTING HEIGHT PRIOR TO INSTALL.

EP15 EXTEND CIRCUIT FOR HYDRONIC PUMP THROUGH ASSOCIATED VFD (PROVIDED BY DIV. 23) TO TERMINATION POINT AT PUMP. COORDINATE FINAL LOCATION WITH MECHANICAL CONTRACTOR PRIOR TO INSTALL.

EP16 PROVIDE 120V CONNECTION TO PROJECTOR SCREEN. PROVIDE SINGLE-GANG ROUGH-IN FOR FUTURE CONTROL STATION AND ROUTE CIRCUIT THROUGH CONTROL STATION TO TERMINATION POINT AT SCREEN. PROVIDE (1) 3/4" CONDUIT FROM CONTROL STATION LOCATION TO WALL BOX IN ROOM. COORDINATE FINAL LOCATION WITH OWNER PRIOR TO ROUGH-IN.

EP17 PROVIDE CEILING-MOUNTED RECEPTACLE FOR PROJECTOR. COORDINATE FINAL EQUIPMENT LOCATION PRIOR TO INSTALL.

EP18 DUPLEX RECEPTACLE INTENDED TO SERVE FUME HOOD. COORDINATE FINAL EQUIPMENT LOCATION PRIOR TO ROUGH-IN.

TAGGED NOTES

EP19 PROVIDE 120V CONNECTION TO AUTOMATIC FAUCET. COORDINATE FINAL CONNECTION REQUIREMENTS WITH EQUIPMENT VENDOR PRIOR TO INSTALL.

EP20 PROVIDE 208V CONNECTION FOR MOTORIZED COILING DOOR. INSTALL VENDOR-FURNISHED CONTROL STATION AND ROUTE CIRCUIT THROUGH CONTROL STATION TO TERMINATION POINT AT DOOR MOTOR. COORDINATE FINAL LOCATION WITH OWNER PRIOR TO ROUGH-IN.

EP25 PROVIDE (1) #12 GROUND IN 3/4" FROM PANEL 'WET LAB' AND CONNECT TO GROUNDING LUG/SCREW AT FLAMMABLES CABINET. COORDINATE FINAL CONNECTION REQUIREMENTS WITH EQUIPMENT VENDOR PRIOR TO INSTALL.

EP27 CONNECT CIRCUIT TO INTEGRAL DISCONNECT AT FAN COIL UNIT. COORDINATE INSTALL WITH MECHANICAL CONTRACTOR.

EP28 PROVIDE 120V CONNECTION TO STEP-DOWN TRANSFORMER FOR CAV/VAV BOXES. COORDINATE FINAL LOCATION WITH MECHANICAL CONTRACTOR.

EP29 EXTEND CIRCUIT FOR DOAS UNIT THROUGH ASSOCIATED VFD (PROVIDED BY DIV. 23) TO TERMINATION POINT AT UNIT. COORDINATE FINAL LOCATION WITH MECHANICAL CONTRACTOR PRIOR TO INSTALL.

EP30 PROVIDE 120V CONNECTION TO BAS PANEL. COORDINATE INSTALL WITH MECHANICAL CONTRACTOR.

EP31 COORDINATE FINAL LOCATION AND ORIENTATION OF FLOOR BOX WITH ARCHITECT'S FINAL FURNITURE PLAN BEFORE ROUGH-IN.

EP33 PROVIDE 240V, 600A/3P, NEMA 1, FUSIBLE SERVICE ENTRANCE RATED DISCONNECT SWITCH FOR PV SYSTEM. PROVIDE WITH 600A FUSES.

EP40 CONNECT CIRCUIT TO INTEGRAL DISCONNECT AT UNIT HEATER. COORDINATE INSTALL WITH MECHANICAL CONTRACTOR.

EP41 PROVIDE 120V CONNECTION FOR FIRE ALARM CONTROL PANEL. CONFIRM FINAL LOCATION OF FACP PRIOR TO ROUGH-IN.

EP42 PROVIDE 120V CONNECTION TO DOOR FOR ELECTRONIC HARDWARE. PROVIDE (4) 2" CONDUITS FROM PV PANEL UP TO ROOF AND CAP FOR FUTURE USE.


EP44 TERMINATE CIRCUIT IN ABOVE-CEILING JUNCTION BOX FOR FUTURE PROJECTOR CONNECTION.

EP45 PROVIDE 120V CONNECTION TO SNORKEL SHADE. COORDINATE INSTALL WITH MECHANICAL CONTRACTOR.

EP46 PROVIDE 120V CONNECTION TO MOTORIZED SHEDS. EXTEND CIRCUIT TO MULTIPLE MOTORS AS REQUIRED. COORDINATE INSTALL WITH SHADE VENDOR.

EP49 PROVIDE LEGRAND S208305TRG16 3FT SELF TEST GFCI 5-OUTLET PLUGMOLD (OR EQUIVALENT) AND INSTALL AT INDICATED MOUNTING HEIGHT. COORDINATE FINAL LOCATION WITH OWNER PRIOR TO INSTALL.

EP50 PROVIDE LEGRAND PM87C 4FT 5-OUTLET PLUGMOLD (OR EQUIVALENT) AND INSTALL AT INDICATED MOUNTING HEIGHT. COORDINATE FINAL LOCATION WITH OWNER PRIOR TO INSTALL.

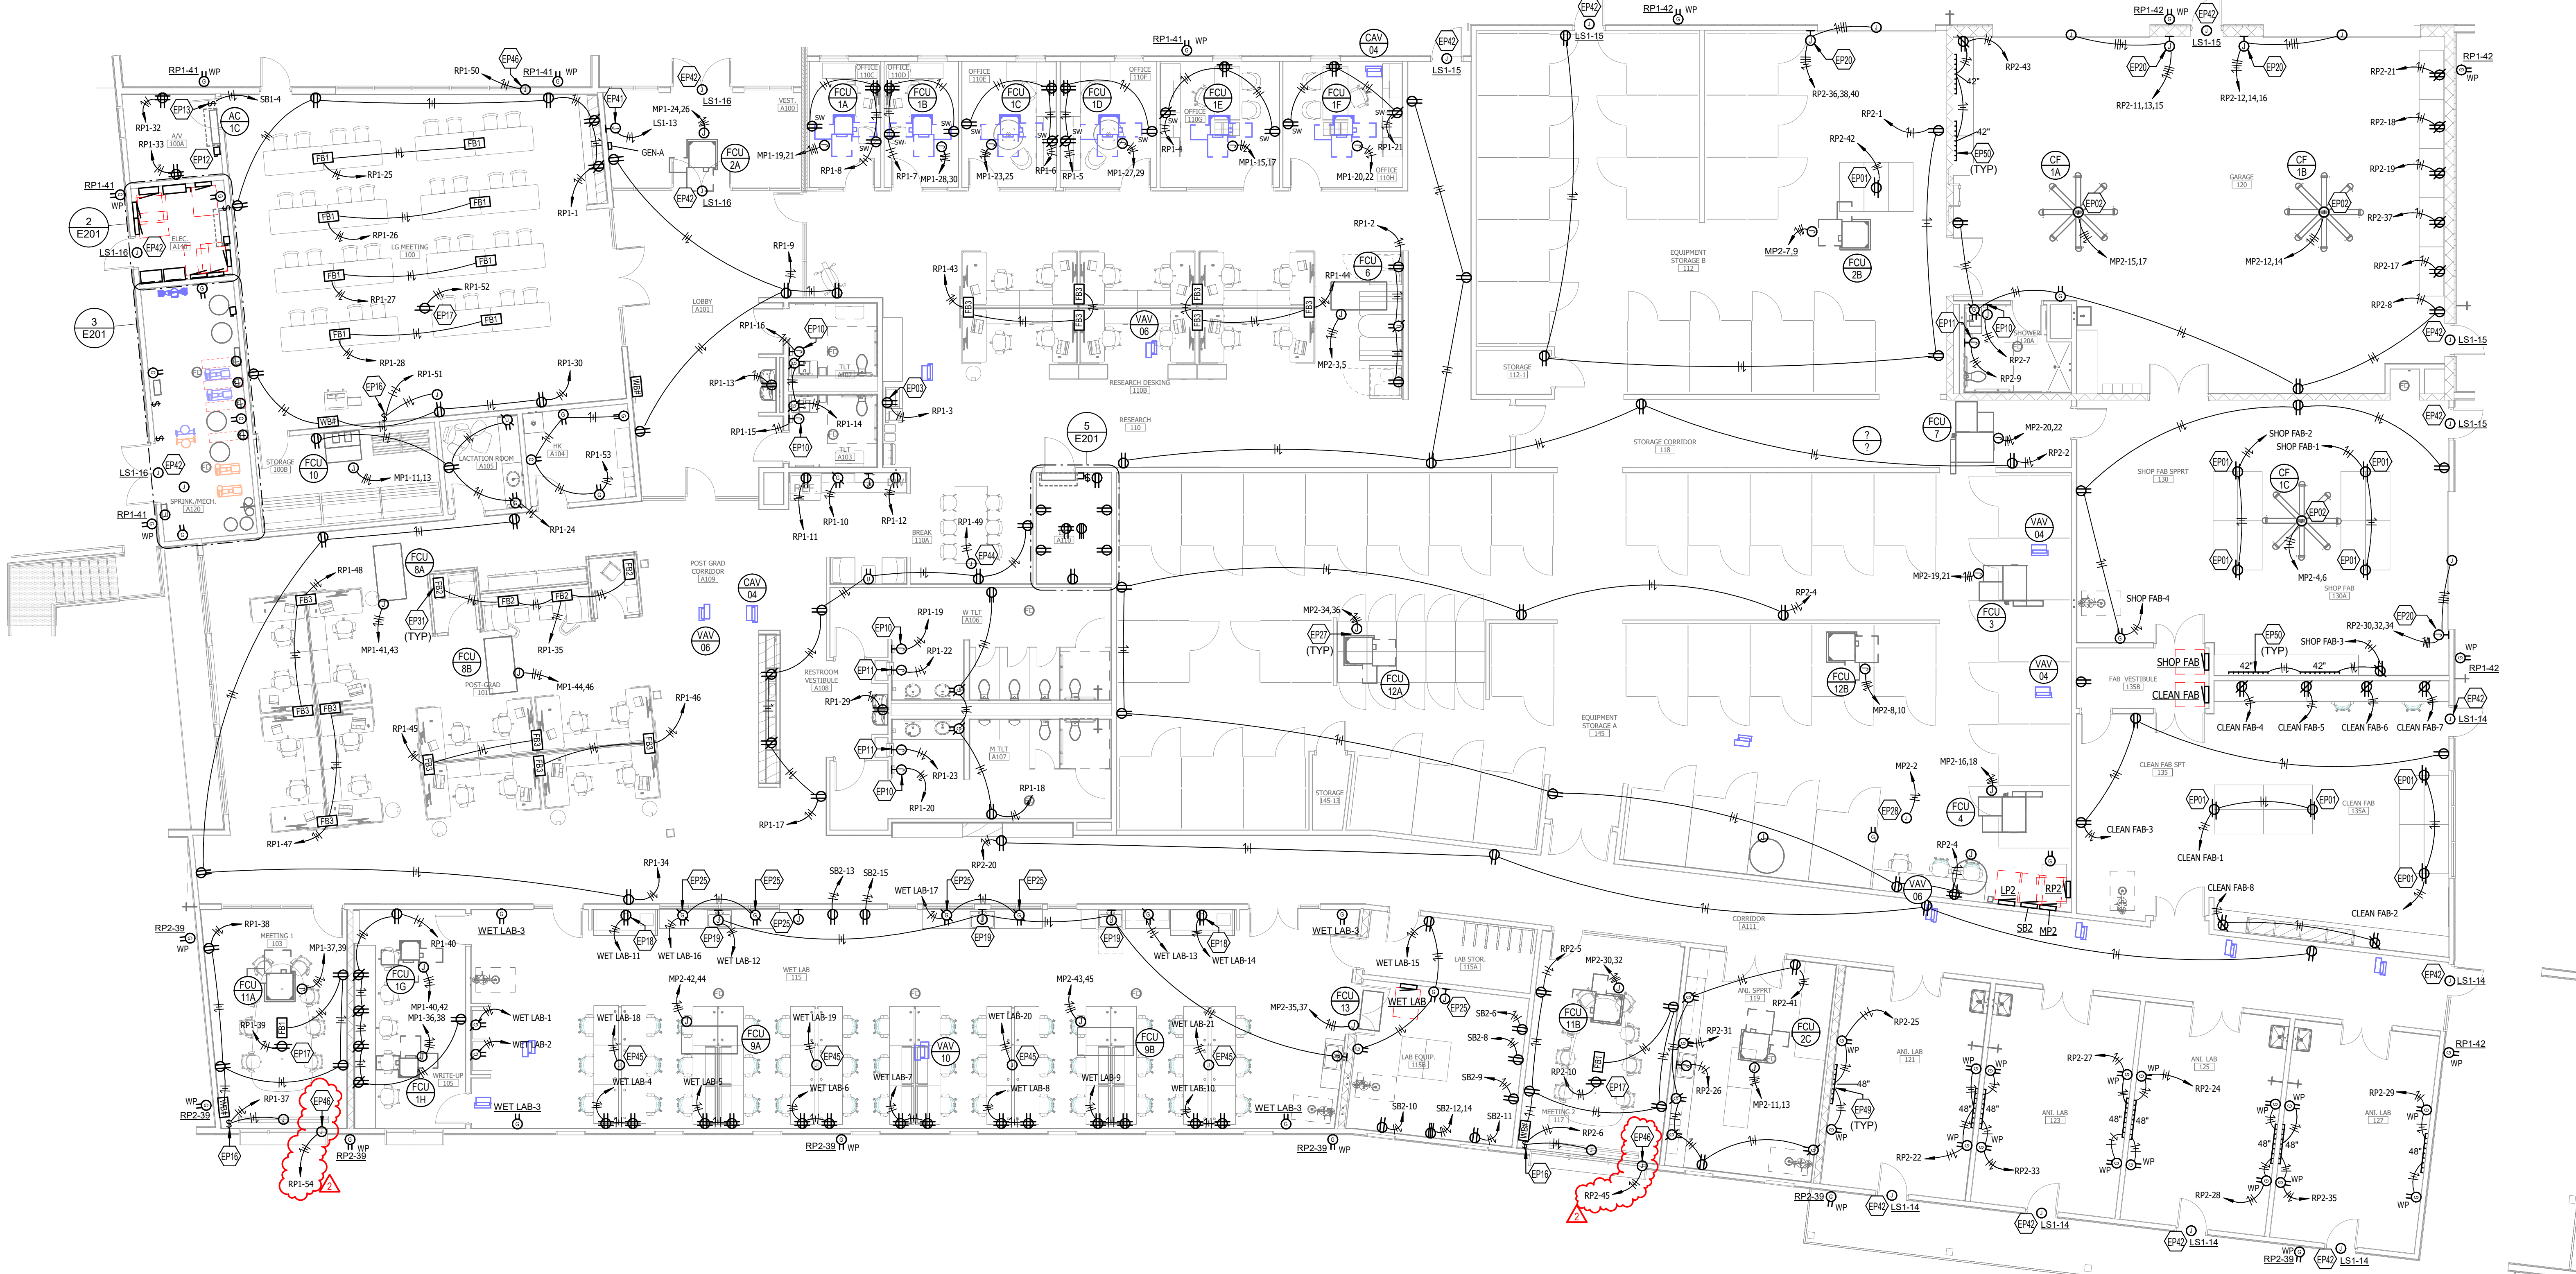


1 ELECTRICAL POWER FLOOR PLAN - FIRST FLOOR
1/8" = 1'-0" 1/8" = 1'-0"

6/4/2026 3:02:22 PM

Autodesk Docs/2405 - Virginia Tech Center Woods/VT Center Woods Electrical E201.rvt

400 Granby Street
Suite 301
Norfolk, VA 23510
wparch.com 757.227.5310

WPA
WORK PROGRAM ARCHITECTS

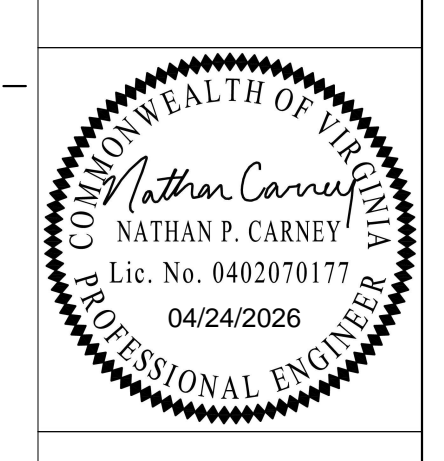

VIRGINIA TECH
IMPROVE CENTER WOODS COMPLEX
697 INVENTIVE LANE, BLACKSBURG, VA 24061
PERMIT SET

PROJECT #	229-18699-000
DATE	04/24/2026
REVISIONS:	
#1 DESCRIPTION	DATE
2 Addendum No. 4	6/5/26

E201
ELECTRICAL POWER FLOOR PLANS

PANELBOARD AND WIRING SCHEDULE																
PANEL: MDP1				MAINS TYPE: MCB				PANEL INTERRUPTING RATING: 42 KAIC								
VOLTAGE: 208Y/120V/3P/4W				SPD: Yes				LOCATION: ELEC. A140								
AMPERES: 1200 A				MOUNTING: SURFACE				SUPPLY FROM:								
NOTES	VD %	CIRCUIT DESCRIPTION	HOT, NEUT, GND	OC	P	CKT	A	B	C	CKT	P	OC	HOT, NEUT, GND	CIRCUIT DESCRIPTION	VD %	NOTES
	0.32%	RP1	3#1, 1#1, 1#0	125	3	1	14.5	9.4		2	4	3	125	3#430, 1#430, 1#42	RP2	1.03%
	0.23%	MP1	2#1, 1#1, 1#0, 1#430, 1#43	400	3	7	42.9	9.5		8	3	125	3#420, 1#420, 1#44	MP2	1.14%	
	0.18%	LP1	3#6, 1#6, 1#0	50	3	15	1.7	1.4		14	3	30	3#6, 1#6, 1#0	LP2	0.90%	
	1.13%	WET LAB	3#4, 1#4, 1#0	50	3	21	4.0	1.9		22	3	50	3#6, 1#6, 1#0	SHOP FAB	1.09%	
	0.76%	CLEAN FAB	3#6, 1#6, 1#0	50	3	27	0.7	0.4		28	3	125	3#110, 1#110, 1#6	ATS-SB	0.20%	
	0.19%	ATS-SLS	3#6, 1#6, 1#0	50	3	31	2.9			32						
				101.9 kVA				97.5 kVA				85.3 kVA				
				865 A				828 A				711 A				
LOAD CLASSIFICATION				CONNECTED LOAD	DEMAND FACTOR	ESTIMATED DEMAND		PANEL TOTALS								
EQUIP				30640 VA	100.00%	30640 VA		TOTAL CONNECTED LOAD: 285 kVA								
HVAC				153294 VA	100.00%	153294 VA		TOTAL ESTIMATED DEMAND: 228 kVA								
LTNG				12044 VA	125.00%	15055 VA		TOTAL CONNECTED CURRENT: 790 A								
REC				68780 VA	57.27%	39390 VA		TOTAL ESTIMATED DEMAND CURRENT: 717 A								

PANELBOARD AND WIRING SCHEDULE																
PANEL: LP2				MAINS TYPE: MCB				PANEL INTERRUPTING RATING: 42 KAIC								
VOLTAGE: 208Y/120V/3P/4W				SPD: No				LOCATION: EQUIPMENT STORAGE A 145								
AMPERES: 50 A				MOUNTING: SURFACE				SUPPLY FROM: MDP1								
NOTES	VD %	CIRCUIT DESCRIPTION	HOT, NEUT, GND	OC	P	CKT	A	B	C	CKT	P	OC	HOT, NEUT, GND	CIRCUIT DESCRIPTION	VD %	NOTES
	2.27%	STOR. GARAGE IS. SHOR.	1#10, 1#10, 1#10	20	1	1	11.1	0.4		2	1	20	1#12, 1#12, 1#12	STOR. CLEAN FAB LTNG	0.17%	
	1.51%	CORR & AN LAB LTNG	1#12, 1#12, 1#12	20	1	3		0.8	0.7	4	1	20	1#12, 1#12, 1#12	CORR & STORAGE LTNG	1.87%	
	0.43%	EQUIP PLATFORM LTNG	1#12, 1#12, 1#12	20	1	5		0.1	0.5	6	1	20	1#12, 1#12, 1#12	CORR & STORAGE LTNG	1.98%	
	0.00%	SPARE	--	20	1	7	0.0	0.0		8	1	20	--	SPARE	0.00%	
	0.00%	SPARE	--	20	1	9		0.0	0.0	10	1	20	--	SPARE	0.00%	
	0.00%	SPARE	--	20	1	11		0.0	0.0	12	1	20	--	SPARE	0.00%	
	0.00%	SPARE	--	20	1	13	0.0	0.0		14	1	20	--	SPARE	0.00%	
	0.00%	SPARE	--	20	1	15		0.0	--	16	1	20	--	SPARE	0.00%	
	0.00%	SPARE	--	20	1	17		--	--	18	1	20	--	SPARE	0.00%	
	0.00%	SPARE	--	20	1	19		--	--	20	1	20	--	SPARE	0.00%	
	0.00%	SPARE	--	20	1	21		--	--	22	1	20	--	SPARE	0.00%	
	0.00%	SPARE	--	20	1	23		--	--	24	1	20	--	SPARE	0.00%	
	0.00%	SPARE	--	20	1	25		--	--	26	1	20	--	SPARE	0.00%	
	0.00%	SPARE	--	20	1	27		--	--	28	1	20	--	SPARE	0.00%	
	0.00%	SPARE	--	20	1	29		--	--	30	1	20	--	SPARE	0.00%	
				14 kVA				15 kVA				0.6 kVA				
				13 A				14 A				5 A				
LOAD CLASSIFICATION				CONNECTED LOAD	DEMAND FACTOR	ESTIMATED DEMAND		PANEL TOTALS								
LTNG				3562 VA	125.00%	4453 VA		TOTAL CONNECTED LOAD: 4 kVA								
								TOTAL ESTIMATED DEMAND: 4 kVA								
EQUIP				12600 VA	100.00%	12600 VA		TOTAL CONNECTED CURRENT: 10 A								
HVAC				109206 VA	100.00%	109206 VA		TOTAL ESTIMATED DEMAND CURRENT: 12 A								

PANELBOARD AND WIRING SCHEDULE																
PANEL: PV1				MAINS TYPE: MCB				PANEL INTERRUPTING RATING: 42 KAIC								
VOLTAGE: 208Y/120V/3P/4W				SPD: No				LOCATION: ELEC. A140								
AMPERES: 600 A				MOUNTING: SURFACE				SUPPLY FROM:								
NOTES	VD %	CIRCUIT DESCRIPTION	HOT, NEUT, GND	OC	P	CKT	A	B	C	CKT	P	OC	HOT, NEUT, GND	CIRCUIT DESCRIPTION	VD %	NOTES
						1				2						
						3				4						
						5				6						
						7				8						
						9				10						
						11				12						
						13				14						
						15				16						
						17				18						
						19				20						
						21				22						
						23				24						
						25				26						
						27				28						
						29				30						
				0.0 kVA				0.0 kVA				0.0 kVA				
				0 A				0 A				0 A				
LOAD CLASSIFICATION				CONNECTED LOAD	DEMAND FACTOR	ESTIMATED DEMAND		PANEL TOTALS								
								TOTAL CONNECTED LOAD: 0 kVA								
								TOTAL ESTIMATED DEMAND: 0 kVA								
								TOTAL CONNECTED CURRENT: 0 A								
								TOTAL ESTIMATED DEMAND CURRENT: 0 A								

NOTES: WHERE NOT LISTED, WIRE AND CONDUIT SHALL BE BE MINIMUM PER SPECIFICATIONS. SPARE BREAKERS TO BE 20A/1P.

PANELBOARD AND WIRING SCHEDULE																
PANEL: LS1				MAINS TYPE: MCB				PANEL INTERRUPTING RATING: 42 KAIC								
VOLTAGE: 208Y/120V/3P/4W				SPD: Yes				LOCATION: ELEC. A140								
AMPERES: 50 A				MOUNTING: SURFACE				SUPPLY FROM: ATLS-S								
NOTES	VD %	CIRCUIT DESCRIPTION	HOT, NEUT, GND	OC	P	CKT	A	B	C	CKT	P	OC	HOT, NEUT, GND	CIRCUIT DESCRIPTION	VD %	NOTES
	3.21%	CORRIDOR RR & IT. E.	1#10, 1#10, 1#10	20	1	1	0.9			2	1	20	1#12, 1#12, 1#12	NORTH EXTERIOR LTNG	0.38%	
	2.22%	IRON LG MTS. ENTRY & E.	1#48, 1#48, 1#48	20	1	3		1.0	0.1	4	1	20	1#12, 1#12, 1#12	EAST EXTERIOR LTNG	1.31%	
	2.31%	CORR. EQUIP.	1#10, 1#10, 1#10	20	1	5		0.5	0.2	6	1	20	1#12, 1#12, 1#12	SOUTH EXTERIOR LTNG	1.25%	
	2.38%	SHOP & CLEAN FAB. S.	1#12, 1#12, 1#12	20	1	7	0.3	0.1		8	1	20	1#12, 1#12, 1#12	CORRIDOR & AN. LAB. E.	2.39%	
	2.04%	WETBANK LAB. MFG. AN.	1#12, 1#12, 1#12	20	1	9		0.2	0.3	10	1	20	1#12, 1#12, 1#12	MTO. WRITE UP AVET.	0.81%	
	1.04%	BAS. PANEL 200	1#12, 1#12, 1#12	20	1	11		0.2	0.2	12	1	20	1#12, 1#12, 1#12	DOOR HARDWARE, SE.	2.59%	
	1.01%	FACP A100	1#12, 1#12, 1#12	20	1	13	0.5	0.5		14	1	20	1#12, 1#12, 1#12	DOOR HARDWARE, NW.	1.89%	
	1.89%	DOOR HARDWARE, NE.	1#12, 1#12, 1#12	20	1	15		0.3	0.8	16	1	20	1#12, 1#12, 1#12	DOOR HARDWARE, SW.	1.89%	
	0.33%	FP AIR COMPRESSOR	2#12, 1#12, 1#12	20	2	17		0.6	0.0	18	1	20	--	SPARE	0.00%	
	0.00%	SPARE	--	20	2	19	0.6	0.0		20	1	20	--	SPARE	0.00%	
	0.00%	SPARE	--	20	1	21		--	--	22	1	20	--	SPARE	0.00%	
	0.00%	SPARE	--	20	1	23		--	--	24	1	20	--	SPARE	0.00%	
	0.00%	SPARE	--	20	1	25		--	--	26	1	20	--	SPARE	0.00%	
	0.00%	SPARE	--	20	1	27		--	--	28	1	20	--	SPARE	0.00%	
	0.00%	SPARE	--	20	1	29		--	--	30	1	20	--	SPARE	0.00%	
				29 kVA				27 kVA				17 kVA				
				25 A				23 A				14 A				
LOAD CLASSIFICATION				CONNECTED LOAD	DEMAND FACTOR	ESTIMATED DEMAND		PANEL TOTALS								
EQUIP				3400 VA	100.00%	3400 VA		TOTAL CONNECTED LOAD: 7 kVA								
LTNG				3803 VA	125.00%	4754 VA		TOTAL ESTIMATED DEMAND: 8 kVA								
								TOTAL CONNECTED CURRENT: 20 A								
								TOTAL ESTIMATED DEMAND CURRENT: 23 A								

PANELBOARD AND WIRING SCHEDULE																
PANEL: MP1				MAINS TYPE: MCB				PANEL INTERRUPTING RATING: 42 KAIC								
VOLTAGE: 208Y/120V/3P/4W				SPD: No				LOCATION: ELEC. A140								
AMPERES: 400 A				MOUNTING: SURFACE				SUPPLY FROM: MDP1								
NOTES	VD %	CIRCUIT DESCRIPTION	HOT, NEUT, GND	OC	P	CKT	A	B	C	CKT	P	OC	HOT, NEUT, GND	CIRCUIT DESCRIPTION	VD %	NOTES
	1.42%	P-2B A120	2#12, 1#12, 1#12	20	2	1	3.0	3.0		2	1	20	2#12, 1#12, 1#12	P-1B A120	1.19%	
	0.41%	HPC	3#420, 1#420, 1#6	175	3	7	14.5	14.5		8	3	175	3#420, 1#420, 1#6	HPC	0.39%	
	0.70%	FCU-10 100B	2#12, 1#12, 1#12	15	2	11	1.1	0.6		12	2	20	2#12, 1#12, 1#12	EF-1	0.97%	
	0.04%	FCU-11 110G	2#12, 1#12, 1#12	15	2	15	0.0	0.6		16	2	20	2#12, 1#12, 1#12	EF-2	1.13%	
	0.03%	FCU-11 110C	2#12, 1#12, 1#12	15	2	21	0.0	0.0		22	2	15	2#12, 1#12, 1#12	FCU-11 110H	0.06%	
	0.04%	FCU-11 110E	2#12, 1#12, 1#12	15	2	23	0.0	0.2		24	2	15	2#12, 1#12, 1#12	FCU-2 A100	0.15%	
	0.04%	FCU-11 110F	2#12, 1#12, 1#12	15	2	29	0.0	0.0		30	2	15	2#12, 1#12, 1#12	FCU-11 110D	0.03%	
	0.20%	DWH-1 A120	3#6, 1#6, 1#0	50	3	31	4.1	0.2		32	1	20	1#12, 1#12, 1#12	HPC CONTROL PANEL	0.43%	
	0.26%	FCU-11 103	2#12, 1#12, 1#12	15	2	37	0.2	0.0		38	2	15	2#12, 1#12, 1#12	FCU-11 105	0.04%	
	0.69%	FCU-8 101	2#12, 1#12, 1#12	20	2	43	0.8	0.8		44	2	15	2#12, 1#12, 1#12	FCU-8 101	0.90%	
	0.52%	UH-1 A120	2#12, 1#12, 1#12	20	2	45	0.8	0.8		46	2	15	2#12, 1#12, 1#12	FCU-11 105	0.04%	
	0.00%	SPARE	--	20	1	47		--	--							

SITE - GENERAL NOTES

- A. DO NOT SCALE FROM MECHANICAL AND ELECTRICAL DRAWINGS. FIELD VERIFY REQUIRED DIMENSIONS AND COORDINATE WITH CIVIL DRAWINGS AND SURVEYS.
- B. REFER ALSO TO ALL OTHER PLANS AND THE SPECIFICATION, BUT ESPECIALLY TO: THE SITE SURVEY, THE ARCHITECTURAL SITE PLAN, THE SITE GRADING PLAN, THE PLANTING PLAN (WHERE AVAILABLE), FOUNDATION PLAN(S), APPROPRIATE MECHANICAL & ELECTRICAL FLOOR PLANS FOR SERVICE CONTINUATIONS, THE SITE UTILITY PLAN - MECHANICAL & ELECTRICAL. WHERE THERE ARE CONFLICTS AMONG THESE PLANS AND/OR RELATED SPECIFICATIONS, ADVISE THESE ENGINEERS AT LEAST TEN DAYS PRIOR TO SUBMISSION OF BIDS.
- C. ALL FEES AND ANY OTHER COSTS TO UTILITY COMPANIES, MUNICIPALITIES, INSPECTORS, REVIEWING AGENCIES, ETC. ARE TO BE INCLUDED AS A PART OF THIS CONTRACT.
- D. STATE CODES, RULES, REGULATIONS AND REQUIREMENTS APPLY UNLESS EXCEEDED BY THIS DESIGN.
- E. WHEN INTERRUPTION OF AN EXISTING UTILITY OR SERVICE IS PLANNED OR OCCURS ACCIDENTALLY, THE CONTRACTOR(S) SHALL WORK CONTINUOUSLY AS NEEDED TO RESTORE SAME PROVIDING PREMIUM TIME AS NEEDED AT NO INCREASE IN THE CONTRACT PRICE.

SITE - GENERAL NOTES

- F. LOCATIONS, DEPTHS, MATERIAL TYPES, ELEVATIONS, ETC. OF ALL APPURTENANCES, LINES, BUILDINGS, ETC. INDICATED ON THESE DRAWINGS WERE TAKEN FROM VARIOUS SOURCES, ARE DIAGRAMMATIC ONLY AND ARE SUBJECT TO SUBSTANTIAL VARIATION FROM EXISTING CONDITIONS. EXISTING UTILITIES LOCATIONS MAY VARY. CONSEQUENTLY ALL CONTRACTORS SHALL EXERCISE EXTREME CARE IN THE COURSE OF THEIR WORK SO AS TO ENSURE THAT THEY DO NOT INTERRUPT ANY EXISTING SERVICE. FOR SAFETY PURPOSES, PAY PARTICULAR ATTENTION TO THIS PRECAUTION RELATIVE TO NATURAL GAS AND ELECTRICAL LINES. ALL WORK SHALL BE PERFORMED IN ACCORDANCE WITH ALL STATE, RULES, REGULATIONS, STANDARDS AND SAFETY REQUIREMENTS.
- G. PROVIDE LONG RADIUS ELBOWS FOR UNDERGROUND CONDUIT BENDS. WHERE SERVING A UTILITY OWNED TRANSFORMER, THE UTILITY STANDARDS SHALL TAKE PRECEDENCE.
- H. UTILITIES SHALL BE INSTALLED IN ACCORDANCE WITH THE APPLICABLE MUNICIPALITY OR UTILITY COMPANY STANDARDS. IN ALL CASES, THE MOST STRINGENT REQUIREMENT SHALL APPLY. IF ANY VARIATION OCCURS, CONSULT THE ENGINEER. CONTRACTOR SHALL VISIT THE SITE AND FIELD VERIFY THE ROUTING OF ALL UTILITIES NEW AND EXISTING PRIOR TO SUBMISSION OF BIDS. SUBMISSION OF A BID PROPOSAL INDICATES THAT THE CONTRACTOR IS FULLY AWARE OF ALL OBSTRUCTIONS AND WILL INSTALL ALL OF THE NEW UTILITIES WITHOUT REQUESTS FOR ANY ADDITIONAL CHANGES.

SITE - GENERAL NOTES

- I. PROVIDE PVC FOR EXTERIOR UNDERGROUND TRANSITIONS TO ABOVE GRADE. EXTEND CONDUIT A MINIMUM OF 6" ABOVE GRADE. GALVANIZED RIGID CONDUIT IS NOT ALLOWED.
- J. CONTRACTOR SHALL PERFORM A SMOKE TEST ON ALL CONDUITS INSTALLED ON SITE AND SHALL TAKE ALL NECESSARY CORRECTIVE ACTION IF NOT FOUND IN COMPLIANCE WITH FACILITY STANDARDS.
- K. CONTRACTOR SHALL CONTACT ENGINEER FOR INSPECTION OF TRENCHES PRIOR TO INSTALLATION OF CONDUITS OR RACEWAYS. PROVIDE PHOTOS UPON REQUEST.
- L. CONTRACTOR SHALL CUT AND PATCH ALL PAVEMENT, CURBING, ETC. AS REQUIRED FOR WORK. CONTRACTOR SHALL REPAIR ALL LANDSCAPING THAT IS DAMAGED FOR WORK. FINISH GRADE, SEED AND STRAW ALL DISTURBED GREEN SPACES. ALL PATCH AND REPAIR WORK SHALL BE IN ACCORDANCE WITH BOTH CIVIL AND LANDSCAPE DRAWINGS AND SPECIFICATIONS.
- M. COORDINATE UNDERGROUND ELECTRICAL WITH ALL LANDSCAPING AND FENCING, ADJUST ELECTRICAL LINES TO AVOID CONFLICTS. REFER TO LANDSCAPING PLANS FOR FURTHER INFORMATION. AVOID ROUTING UNDERGROUND CONDUITS UNDER ROADWAYS OR PARKING LOTS, CROSS ROADWAYS WITH UNDERGROUND CONDUITS AT 90 ANGLES WHERE POSSIBLE.

SITE - GENERAL NOTES

- N. PLANNED INTERRUPTION OF ANY SERVICE SHALL BE COORDINATED WITH THE APPROPRIATE MUNICIPALITY OR UTILITY COMPANY, THE ARCHITECT, AND THE BUILDING OPERATORS AT LEAST ONE WEEK IN ADVANCE OF ANTICIPATED INTERRUPTION. A SCHEDULE FOR THESE OUTAGES SHALL BE DEVELOPED AND AGREED UPON BETWEEN THE PARTIES MENTIONED TO AVOID UNNECESSARY INCONVENIENCE TO THE OWNER OR ANY AFFECTED PARTY. NOTIFY THE UTILITY COMPANY OF ANY ANTICIPATED SERVICES REQUIRED FROM THEM AT LEAST TWO WEEKS IN ADVANCE IN WRITING AND INSURE THAT THEY DO NOT DELAY WORK.
- O. THE LOCATIONS OF UTILITIES SHOWN WITHIN THESE DRAWINGS ARE APPROXIMATE ONLY.
- P. THE CONTRACTOR WILL BE RESPONSIBLE FOR ANY EXCAVATION WORK REQUIRED TO LOCATE UNDERGROUND UTILITIES. THE CONTRACTOR IS ALSO REQUIRED TO NOTIFY ANY OTHER AFFECTED UTILITY OWNERS PRIOR TO DIGGING. IN THE EVENT OF ACCIDENTAL INTERRUPTION OF SERVICE, CONTRACTOR WILL IMMEDIATELY NOTIFY THE OTHER UTILITY OWNERS.
- Q. THE CONTRACTOR WILL PROVIDE ALL NECESSARY PROTECTIVE MEASURES TO SAFEGUARD OTHER EXISTING UTILITIES FROM DAMAGE DURING CONSTRUCTION OF THIS PROJECT. IN THE EVENT THAT SPECIAL EQUIPMENT IS REQUIRED TO WORK OVER AND AROUND THE OTHER UTILITIES, THE UTILITY WILL BE REQUIRED TO FURNISH SUCH EQUIPMENT.



SITE - GENERAL NOTES

- R. CONTRACTOR SHALL PAY ALL TAP FEES, UTILITY COST, UTILITY CONNECTION COSTS, METER FEES, EXTENSION AND DEVELOPMENT CHARGES, REFER TO THE SPECIFICATIONS FOR ADDITIONAL REQUIREMENTS.
- S. THE UTILITY WILL PROVIDE STAKING DATA INCLUDING NORthing AND EASTING DATA AS REQUIRED OR SHOWN ON DRAWINGS.
- T. REATTACH ALL TAPS AND TRANSFORMERS AS TO MAINTAIN EXISTING PHASE CONNECTIONS.
- U. CONTRACTOR RESPONSIBLE FOR MAINTAINING DOWNSTREAM SERVICE FROM REMOVED EQUIPMENT ON SITE, INCLUDING BUT NOT LIMITED TO SITE LIGHTING, TRANSFORMERS, ETC.
- V. WHEN DEMOLITION OF AN ELECTRICAL DEVICE (OR CIRCUIT) IS INDICATED ON THE DRAWINGS, THE CONTRACTOR SHALL ENSURE THAT OTHER DEVICES OR EQUIPMENT "UPSTREAM" OR "DOWNSTREAM" ON THE CIRCUITS SHALL REMAIN IN "PRE-DEMOLITION" WORKING ORDER. "LEFT-OVER" CIRCUIT BREAKERS SHALL REMAIN, BE SWITCHED TO OFF POSITION, AND BE LABELED AS SPARES IN THEIR PANELS. PROVIDE NEW TYPEWRITTEN DIRECTORIES FOR ALL PANELS AFFECTED.
- W. REMOVE ALL ASSOCIATED BACKBOXES, CONDUIT AND CONDUCTORS FOR DEVICES/FIXTURES, ETC. BEING REMOVED (BACK TO SOURCE), WHETHER INDICATED OR NOT (UON).
- X. COORDINATE DISPOSAL OF ALL FIXTURES, DEVICES, ETC. (INDICATED FOR DEMOLITION) WITH OWNER. TURN OVER ITEMS REMOVED TO OWNER AT THEIR OPTION.
- Y. COORDINATE WITH OTHER TRADES FOR THE REMOVAL AND/OR RELOCATION OF ELECTRICAL DEVICES AND CONNECTIONS ASSOCIATED WITH THEIR EQUIPMENT.

TAGGED NOTES

- UE01 VTES TO PROVIDE (2) 4" CONDUIT AND CONDUCTORS FOR A & B PRIMARY FEEDS TO SITE.
- UE02 VTES TO PROVIDE (1) 4" SPARE CONDUIT TO SITE.
- UE03 VTES TO PROVIDE (1) 2" CONDUIT AND CABLE FOR SCADA FEED TO SITE.
- UE04 VTES TO PROVIDE UTILITY TRANSFORMER AND MAKE ALL INTERNAL TERMINATIONS. CONTRACTOR TO INSTALL VTES-FURNISHED FIBERGLASS WELL.
- UE05 VTES TO PROVIDE MEDIUM-VOLTAGE SWITCH AND MAKE ALL INTERNAL TERMINATIONS. CONTRACTOR TO INSTALL VTES-FURNISHED FIBERGLASS WELL.
- UE06 PROVIDE (1) 4" CONDUIT FROM MEDIUM-VOLTAGE SWITCH TO UTILITY TRANSFORMER. PROVIDE TRANSITIONS FOR CONDUIT TO STUB UP THROUGH CONCRETE PADS AND INSTALL AT A MINIMUM OF 24" BELOW GRADE. VTES TO PROVIDE CONDUCTORS.
- UE07 PROVIDE (1) 1" CONDUIT FROM UTILITY TRANSFORMER TO METER BASE. PROVIDE TRANSITIONS FOR CONDUIT TO STUB UP THROUGH CONCRETE PAD OF TRANSFORMER AND UP INTO BOTTOM OF METER BASE. INSTALL AT A MINIMUM OF 24" BELOW GRADE. VTES TO PROVIDE CONDUCTORS.
- UE08 PROVIDE #10, 1#6 GROUND IN 2.5" CONDUIT FROM UTILITY TRANSFORMER TO 200A FUSED DISCONNECT FOR FUTURE SERVICE. PROVIDE TRANSITIONS FOR CONDUIT TO STUB UP THROUGH CONCRETE PAD OF TRANSFORMER AND UP INTO BOTTOM OF DISCONNECT. INSTALL AT A MINIMUM OF 24" BELOW GRADE.
- UE09 PROVIDE (1) 2" CONDUIT FROM MEDIUM-VOLTAGE SWITCH TO SCADA ENCLOSURE. PROVIDE TRANSITIONS FOR CONDUIT TO STUB UP THROUGH CONCRETE PAD OF SWITCH AND UP INTO BOTTOM OF ENCLOSURE. INSTALL AT A MINIMUM OF 24" BELOW GRADE. VTES TO PROVIDE CABLEING.
- UE11 VTES TO PROVIDE METER (WITH BASE) AND MAKE ALL INTERNAL TERMINATIONS.
- UE12 VTES TO PROVIDE SCADA ENCLOSURE AND MAKE ALL INTERNAL TERMINATIONS.
- UE14 PROVIDE 400V, 200AMP, NEMA-3R FUSED DISCONNECT FOR FUTURE SERVICE. COORDINATE FINAL LOCATION WITH VTES PRIOR TO INSTALL.
- UE15 PROVIDE SECONDARY CONDUITS AND CONDUCTORS FROM UTILITY TRANSFORMER TO SERVICE ENTRANCE; REFER TO ONE-LINE DIAGRAM FOR SIZING INFORMATION. BURY AT A MINIMUM OF 24" BELOW GRADE AND PROVIDE CONCRETE-ENCASED DUCT BANK PER VTES REQUIREMENTS. FIELD COORDINATE EXACT ROUTING.
- UE21 PROVIDE 4" CONDUIT FROM GENERATOR TO BAS PANEL LOCATION IN POWER MECHANICAL ROOM FOR CONTROLS CONNECTIONS. CABLEING SHALL BE PROVIDED BY BAS CONTRACTOR.
- UE22 THE DESIGN SHOWN IS BASED ON CATERPILLAR D50-GC EQUIPMENT AND IS INTENDED ONLY TO SHOW THE GENERAL SIZE, CONFIGURATION, LOCATION, CONNECTIONS AND SUPPORT FOR EQUIPMENT OR SYSTEMS SPECIFIED WITH RELATION TO THE OTHER BUILDING SYSTEMS. SEE SPECIFICATION SECTION 25.32.00 FOR TECHNICAL REQUIREMENTS PERTAINING TO THE EQUIPMENT.
- UE30 PROVIDE CONDUIT FOR UNDERGROUND SECONDARY FROM PAD-MOUNTED TRANSFORMER. LOCATION TO MAIN SERVICE GEAR. REFER TO ONE-LINE DIAGRAM FOR CONDUIT SIZING/QUANTITY INFORMATION AND BURY AT 24" BELOW GRADE MINIMUM.
- UE31 PROVIDE FEEDER FOR STANDBY BRANCH FROM GENERATOR TO ASSOCIATED ATS IN MAIN ELECTRICAL ROOM. REFER TO ONE-LINE DIAGRAM FOR CONDUIT/CONDUCTOR SIZING INFORMATION AND BURY AT 24" BELOW GRADE MINIMUM.
- UE32 PROVIDE FEEDER FOR STANDBY BRANCH FROM GENERATOR TO ASSOCIATED ATS IN MAIN ELECTRICAL ROOM. REFER TO ONE-LINE DIAGRAM FOR CONDUIT/CONDUCTOR SIZING INFORMATION AND BURY AT 24" BELOW GRADE MINIMUM.
- UE33 PROVIDE GENERATOR EPO PUSH BUTTON; COORDINATE FINAL LOCATION WITH OWNER.


TEMPORARY POWER NOTE
 CONTRACTOR IS RESPONSIBLE FOR COORDINATING WITH VTES FOR ALL TEMPORARY POWER MEASURES REQUIRED OVER THE COURSE OF CONSTRUCTION AND FOR PAYING ALL ASSOCIATED COSTS/FEES.

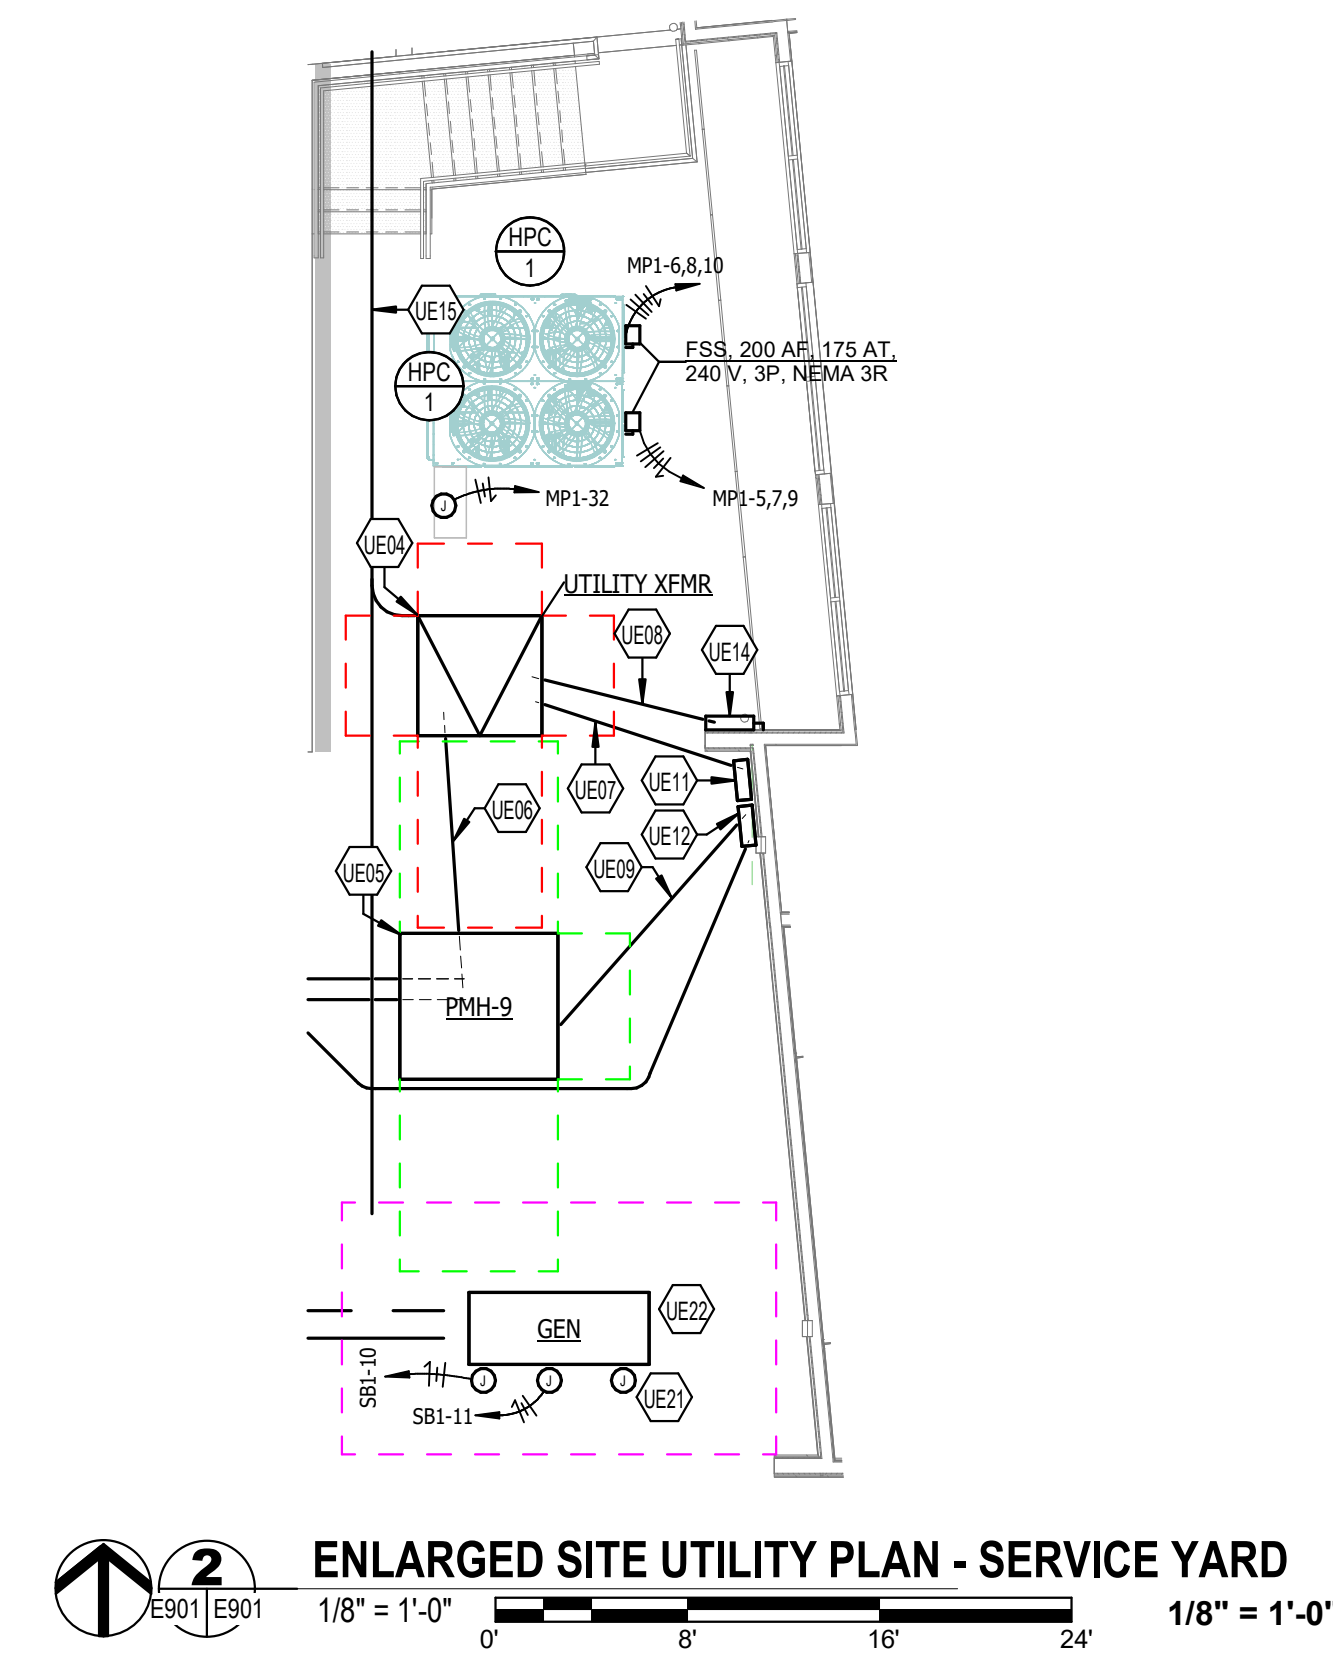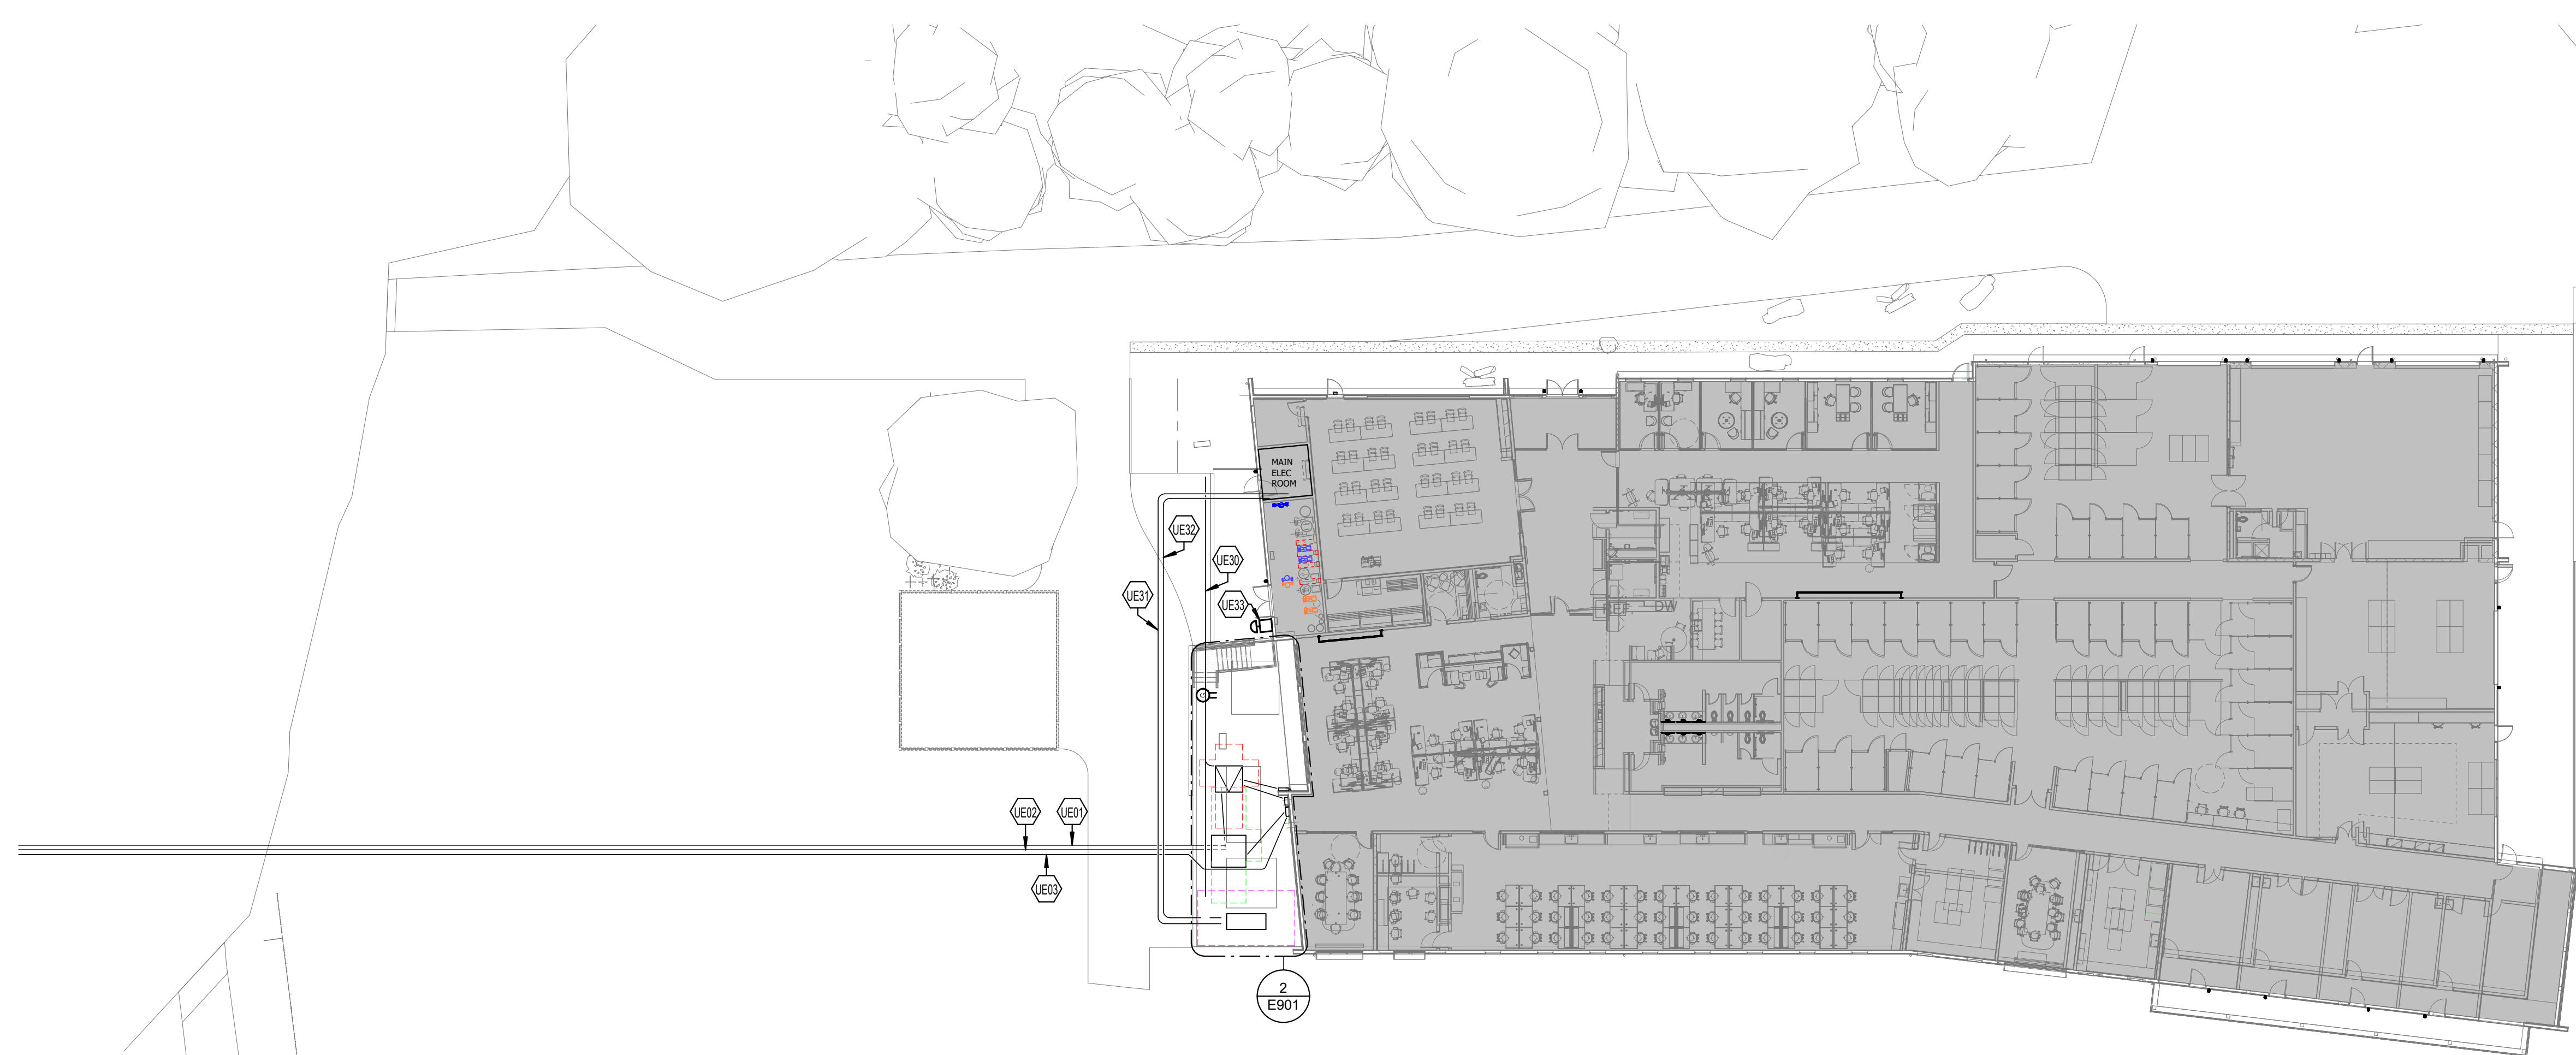

1 ELECTRICAL SITE UTILITY PLAN 1" = 20'

2 ENLARGED SITE UTILITY PLAN - SERVICE YARD 1/8" = 1'-0"

VIRGINIA TECH
IMPROVE CENTER WOODS COMPLEX
 697 INVENTIVE LANE, BLACKSBURG, VA, 24061
 PERMIT SET

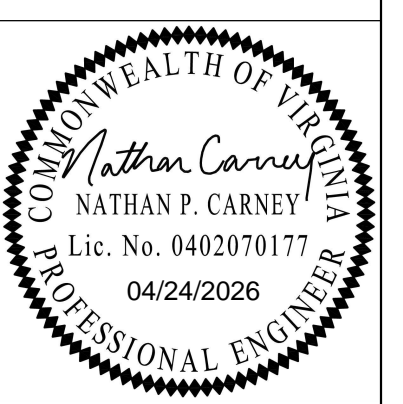

WPA
 WORK PROGRAM ARCHITECTS
 400 Granby Street
 Suite 301
 Norfolk, VA 23510
 wpaarch.com 757.227.5310

PROJECT #	229 - 18699 - 000	
DATE	04/24/2026	
REVISIONS:		
#	DESCRIPTION	DATE
2	Addendum No. 4	6/5/26

E901
 ELECTRICAL SITE UTILITY PLAN



ELECTRICAL SITE UTILITY PLAN - AQUACULTURE RENOVATION - NEW WORK
 1" = 20'-0"
 1" = 20'-0" 0' 20' 40' 80'

SITE - GENERAL NOTES

- A. DO NOT SCALE FROM MECHANICAL AND ELECTRICAL DRAWINGS. FIELD VERIFY REQUIRED DIMENSIONS AND COORDINATE WITH CIVIL DRAWINGS AND SURVEYS.
- B. REFER ALSO TO ALL OTHER PLANS AND THE SPECIFICATION, BUT ESPECIALLY TO: THE SITE SURVEY, THE ARCHITECTURAL SITE PLAN, THE SITE GRADING PLAN, THE PLANTING PLAN (WHERE AVAILABLE), FOUNDATION PLAN(S), APPROPRIATE MECHANICAL & ELECTRICAL FLOOR PLANS FOR SERVICE CONTINUATIONS, THE SITE UTILITY PLAN - MECHANICAL & ELECTRICAL. WHERE THERE ARE CONFLICTS AMONG THESE PLANS AND/OR RELATED SPECIFICATIONS, ADVISE THESE ENGINEERS AT LEAST TEN DAYS PRIOR TO SUBMISSION OF BIDS.
- C. ALL FEES AND ANY OTHER COSTS TO UTILITY COMPANIES, MUNICIPALITIES, INSPECTORS, REVIEWING AGENCIES, ETC. ARE TO BE INCLUDED AS A PART OF THIS CONTRACT.
- D. FEDERAL, STATE, LOCAL, MUNICIPALITY AND UTILITY COMPANY CODES, RULES, REGULATIONS AND REQUIREMENTS APPLY UNLESS EXCEEDED BY THIS DESIGN.
- E. WHEN INTERRUPTION OF AN EXISTING UTILITY OR SERVICE IS PLANNED OR OCCURS ACCIDENTALLY, THE CONTRACTOR(S) SHALL WORK CONTINUOUSLY AS NEEDED TO RESTORE SAME PROVIDING PREMIUM TIME AS NEEDED AT NO INCREASE IN THE CONTRACT PRICE.
- F. LOCATIONS, DEPTHS, MATERIAL TYPES, ELEVATIONS, ETC. OF ALL APPURTENANCES, LINES, BUILDINGS, ETC. INDICATED ON THESE DRAWINGS WERE TAKEN FROM VARIOUS SOURCES, ARE DIAGRAMMATIC ONLY AND ARE SUBJECT TO SUBSTANTIAL VARIATION FROM EXISTING CONDITIONS. EXISTING UTILITIES LOCATIONS MAY VARY. CONSEQUENTLY ALL CONTRACTORS SHALL EXERCISE EXTREME CARE IN THE COURSE OF THEIR WORK SO AS TO ENSURE THAT THEY DO NOT INTERRUPT ANY EXISTING SERVICE. FOR SAFETY PURPOSES, PAY PARTICULAR ATTENTION TO THIS PRECAUTION RELATIVE TO NATURAL GAS AND ELECTRICAL LINES. ALL WORK SHALL BE PERFORMED IN ACCORDANCE WITH ALL FEDERAL, STATE, AND/OR LOCAL RULES, REGULATIONS, STANDARDS AND SAFETY REQUIREMENTS.
- G. PROVIDE LONG RADIUS ELBOWS FOR UNDERGROUND CONDUIT BENDS, WHERE SERVING A UTILITY OWNED TRANSFORMER, THE UTILITY STANDARDS SHALL TAKE PRECEDENCE.
- H. UTILITIES SHALL BE INSTALLED IN ACCORDANCE WITH THE APPLICABLE MUNICIPALITY OR UTILITY COMPANY STANDARDS. IN ALL CASES, THE MOST STRINGENT REQUIREMENT SHALL APPLY. IF ANY VARIATION OCCURS, CONSULT THE ENGINEER. CONTRACTOR SHALL VISIT THE SITE AND FIELD VERIFY THE ROUTING OF ALL UTILITIES NEW AND EXISTING PRIOR TO SUBMISSION OF BIDS. SUBMISSION OF A BID PROPOSAL INDICATES THAT THE CONTRACTOR IS FULLY AWARE OF ALL OBSTRUCTIONS AND WILL INSTALL ALL OF THE NEW UTILITIES WITHOUT REQUESTS FOR ANY ADDITIONAL CHANGES.
- I. PROVIDE GALVANIZED RIGID CONDUIT FOR EXTERIOR UNDERGROUND TRANSITIONS TO ABOVE GRADE; EXTEND CONDUIT A MINIMUM OF 6" ABOVE GRADE.
- J. CONTRACTOR SHALL PERFORM A SMOKE TEST ON ALL CONDUITS INSTALLED ON-SITE AND SHALL TAKE ALL NECESSARY CORRECTIVE ACTION IF NOT FOUND IN COMPLIANCE WITH FACILITY STANDARDS.
- K. CONTRACTOR SHALL CONTACT ENGINEER FOR INSPECTION OF TRENCHES PRIOR TO INSTALLATION OF CONDUITS OR RACEWAYS. PROVIDE PHOTOS UPON REQUEST.
- L. CONTRACTOR SHALL CUT AND PATCH ALL PAVEMENT, CURBING, ETC. AS REQUIRED FOR WORK. CONTRACTOR SHALL REPAIR ALL LANDSCAPING THAT IS DAMAGED FOR WORK. FINISH GRADE, SEED AND STRAW ALL DISTURBED GREEN SPACES. ALL PATCH AND REPAIR WORK SHALL BE IN ACCORDANCE WITH BOTH CIVIL AND LANDSCAPE DRAWINGS AND SPECIFICATIONS.
- M. COORDINATE UNDERGROUND ELECTRICAL WITH ALL LANDSCAPING AND FENCING, ADJUST ELECTRICAL LINES TO AVOID CONFLICTS. REFER TO LANDSCAPING PLANS FOR FURTHER INFORMATION. AVOID ROUTING UNDERGROUND CONDUITS UNDER ROADWAYS OR PARKING LOTS, CROSS ROADWAYS WITH UNDERGROUND CONDUITS AT 90 DEGREES WHENEVER POSSIBLE.
- N. PLANNED INTERRUPTION OF ANY SERVICE SHALL BE COORDINATED WITH THE APPROPRIATE MUNICIPALITY OR UTILITY COMPANY, THE ARCHITECT, AND THE BUILDING OPERATORS AT LEAST ONE WEEK IN ADVANCE OF ANTICIPATED INTERRUPTION. A SCHEDULE FOR THESE OUTAGES SHALL BE DEVELOPED AND AGREED UPON BETWEEN THE PARTIES MENTIONED TO AVOID UNNECESSARY INCONVENIENCE TO THE OWNER OR ANY AFFECTED PARTY. NOTIFY THE UTILITY COMPANY OF ANY ANTICIPATED SERVICES REQUIRED FROM THEM AT LEAST TWO WEEKS IN ADVANCE IN WRITING AND INSURE THAT THEY DO NOT DELAY WORK.
- O. THE LOCATIONS OF UTILITIES SHOWN WITHIN THESE DRAWINGS ARE APPROXIMATE ONLY.
- P. THE CONTRACTOR WILL BE RESPONSIBLE FOR ANY EXCAVATION WORK REQUIRED TO LOCATE UNDERGROUND UTILITIES. THE CONTRACTOR IS ALSO REQUIRED TO NOTIFY ANY OTHER AFFECTED UTILITY OWNERS PRIOR TO DIGGING. IN THE EVENT OF ACCIDENTAL INTERRUPTION OF SERVICE, CONTRACTOR WILL IMMEDIATELY NOTIFY THE OTHER UTILITY OWNERS.
- Q. THE CONTRACTOR WILL PROVIDE ALL NECESSARY PROTECTIVE MEASURES TO SAFEGUARD OTHER EXISTING UTILITIES FROM DAMAGE DURING CONSTRUCTION OF THIS PROJECT. IN THE EVENT THAT SPECIAL EQUIPMENT IS REQUIRED TO WORK OVER AND AROUND THE OTHER UTILITIES, THE UTILITY WILL BE REQUIRED TO FURNISH SUCH EQUIPMENT.
- R. CONTRACTOR SHALL PAY ALL TAP FEES, UTILITY COST, UTILITY CONNECTION COSTS, METER FEES, EXTENSION AND DEVELOPMENT CHARGES. REFER TO THE SPECIFICATIONS FOR ADDITIONAL REQUIREMENTS.
- S. THE UTILITY WILL PROVIDE STAKING DATA INCLUDING NORTHING AND EXISTING DATA AS REQUIRED OR SHOWN ON DRAWINGS.
- T. REATTACH ALL TAPS AND TRANSFORMERS AS TO MAINTAIN EXISTING PHASE CONNECTIONS.
- U. CONTRACTOR RESPONSIBLE FOR MAINTAINING DOWNSTREAM SERVICE FROM REMOVED EQUIPMENT ON SITE, INCLUDING BUT NOT LIMITED TO SITE LIGHTING, TRANSFORMERS, ETC.
- V. WHEN DEMOLITION OF AN ELECTRICAL DEVICE (OR CIRCUIT) IS INDICATED ON THE DRAWINGS, THE CONTRACTOR SHALL ENSURE THAT OTHER DEVICES OR EQUIPMENT "UPSTREAM" OR "DOWNSTREAM" ON THE CIRCUITS SHALL REMAIN IN "PRE-DEMOLITION" WORKING ORDER. "LEFT-OVER" CIRCUIT BREAKERS SHALL REMAIN, BE SWITCHED TO OFF POSITION, AND BE LABELED AS SPARES IN THEIR PANELS. PROVIDE NEW TYPEWRITTEN DIRECTORIES FOR ALL PANELS AFFECTED.
- W. REMOVE ALL ASSOCIATED BACKBOXES, CONDUIT AND CONDUCTORS FOR DEVICES/FIXTURES, ETC. BEING REMOVED (BACK TO SOURCE), WHETHER INDICATED OR NOT (UON).
- X. COORDINATE DISPOSAL OF ALL FIXTURES, DEVICES, ETC. (INDICATED FOR DEMOLITION) WITH OWNER. TURN OVER ITEMS REMOVED TO OWNER AT THEIR OPTION.
- Y. COORDINATE WITH OTHER TRADES FOR THE REMOVAL AND/OR RELOCATION OF ELECTRICAL DEVICES AND CONNECTIONS ASSOCIATED WITH THEIR EQUIPMENT.

TAGGED NOTES

- UE28 COORDINATE WITH VTES FOR RECONNECTION OF NEW FEEDER AT EXISTING METER LOCATION.
- UE29 PROVIDE NEW 240V, 100A/2P, NEMA 1, SERVICE-RATED ENCLOSED CIRCUIT BREAKER AS NEW MAIN SERVICE DISCONNECT. EXTEND NEW SERVICE SECONDARY THROUGH ECB AND CONNECT AT EXISTING PANEL "A".

TEMPORARY POWER NOTE
 CONTRACTOR IS RESPONSIBLE FOR COORDINATING WITH VTES FOR ALL TEMPORARY POWER MEASURES REQUIRED OVER THE COURSE OF CONSTRUCTION AND FOR PAYING ALL ASSOCIATED COSTS/FEES.

400 Granby Street
 Suite 301
 Norfolk, VA 23510
 wparc.com 757.227.5310

WPA
 WORK PROGRAM ARCHITECTS

COMMONWEALTH OF VIRGINIA
 Nathan P. Carney, P.E.
 Lic. No. 0402070177
 04/24/2026
 PROFESSIONAL ENGINEER

VIRGINIA TECH
IMPROVE CENTER WOODS COMPLEX
 697 INVENTIVE LANE, BLACKSBURG, VA, 24061
 PERMIT SET

PROJECT #	229 - 18699 - 000
DATE	04/24/2026
REVISIONS:	
#1 DESCRIPTION	DATE
2 Addendum No. 4	6/5/26

E902
 ELECTRICAL SITE
 UTILITY PLAN -
 AQUACULTURE
 RENOVATION - NEW
 WORK